




S40-1 Non-Rated Acoustic Partition

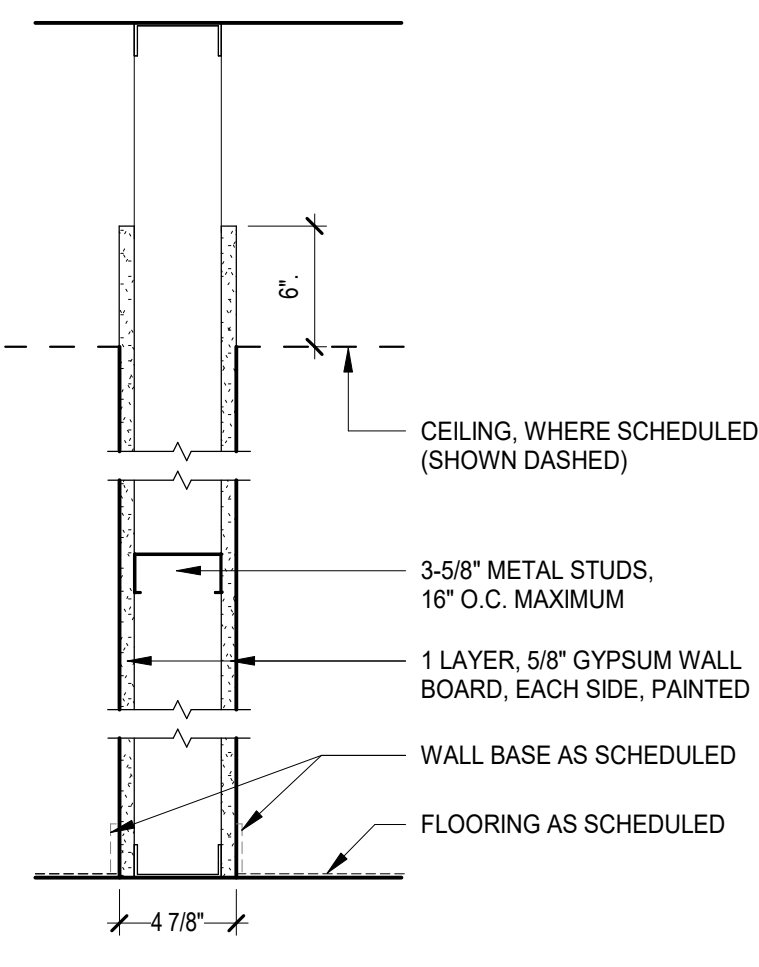


S40-2 Non-Rated Partition

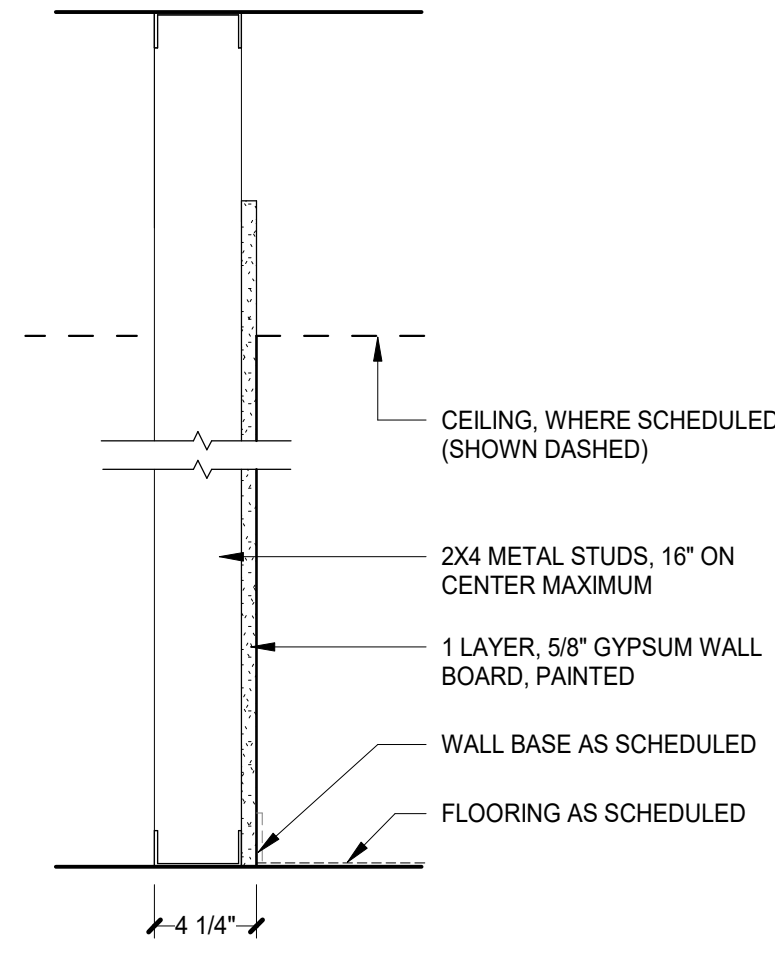


S40-3 Non-Rated Furring Partition

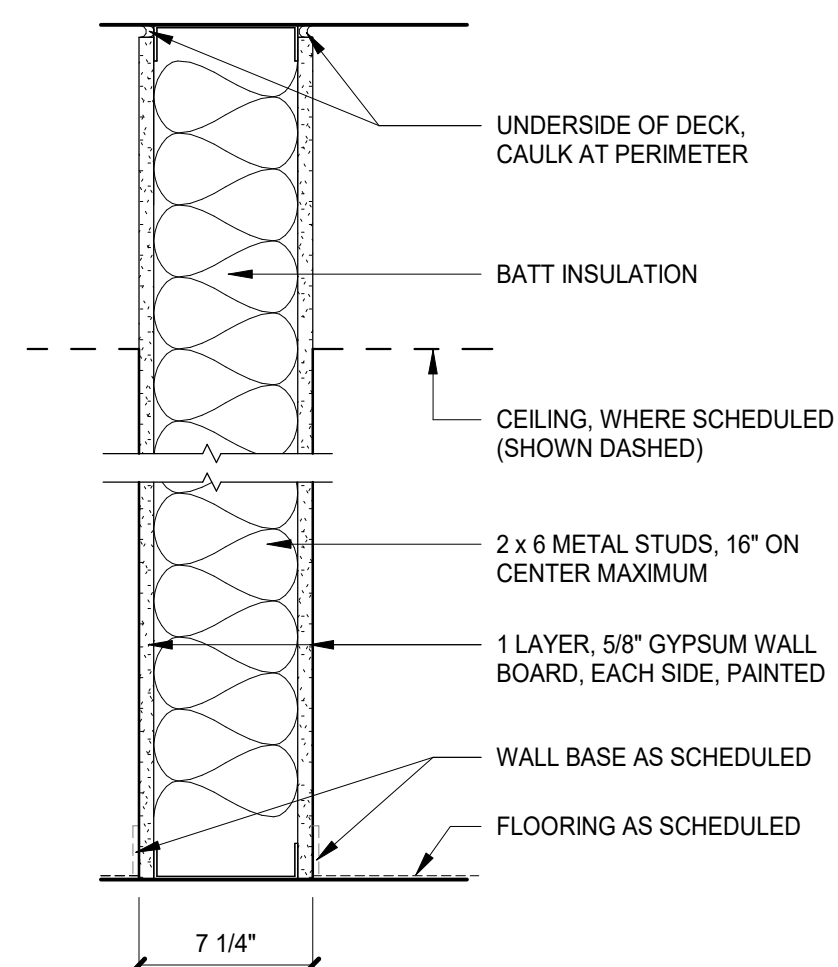


S60-1 Non-Rated Partition

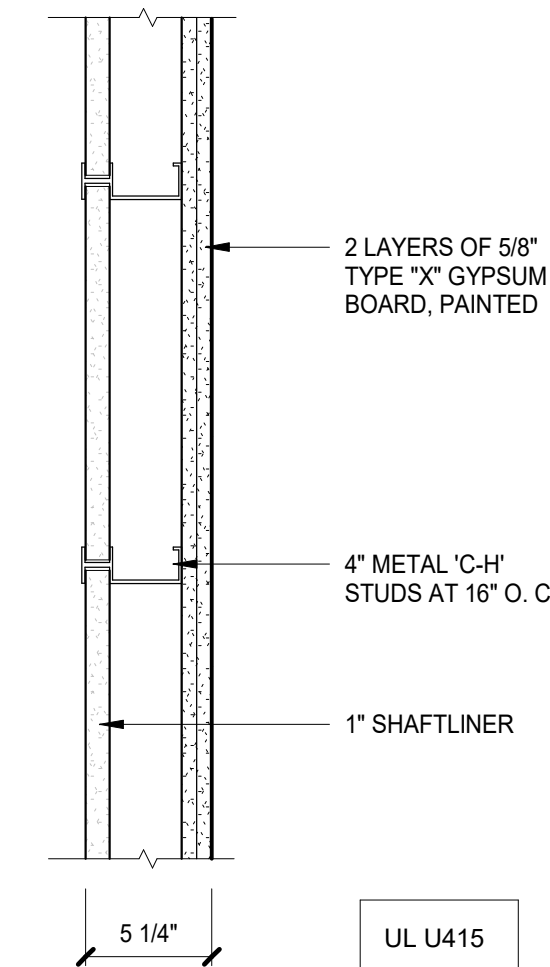


S42-1 2 Hour Rated Shaft-Wall

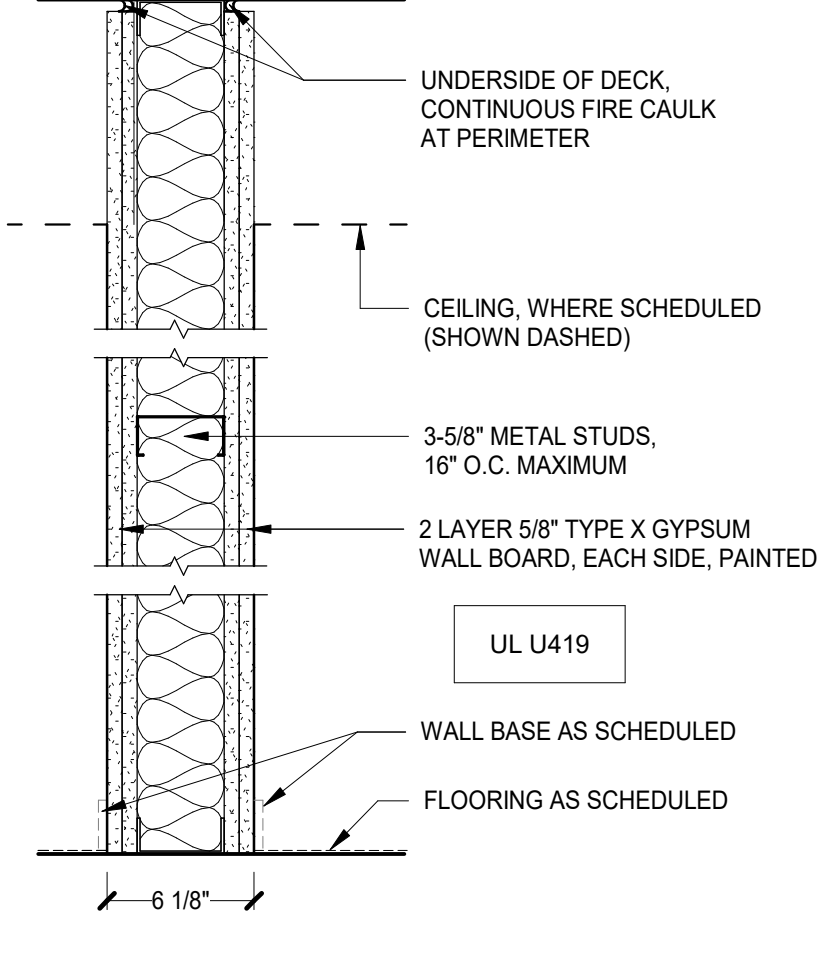


S42-2 2 Hour Rated Partition

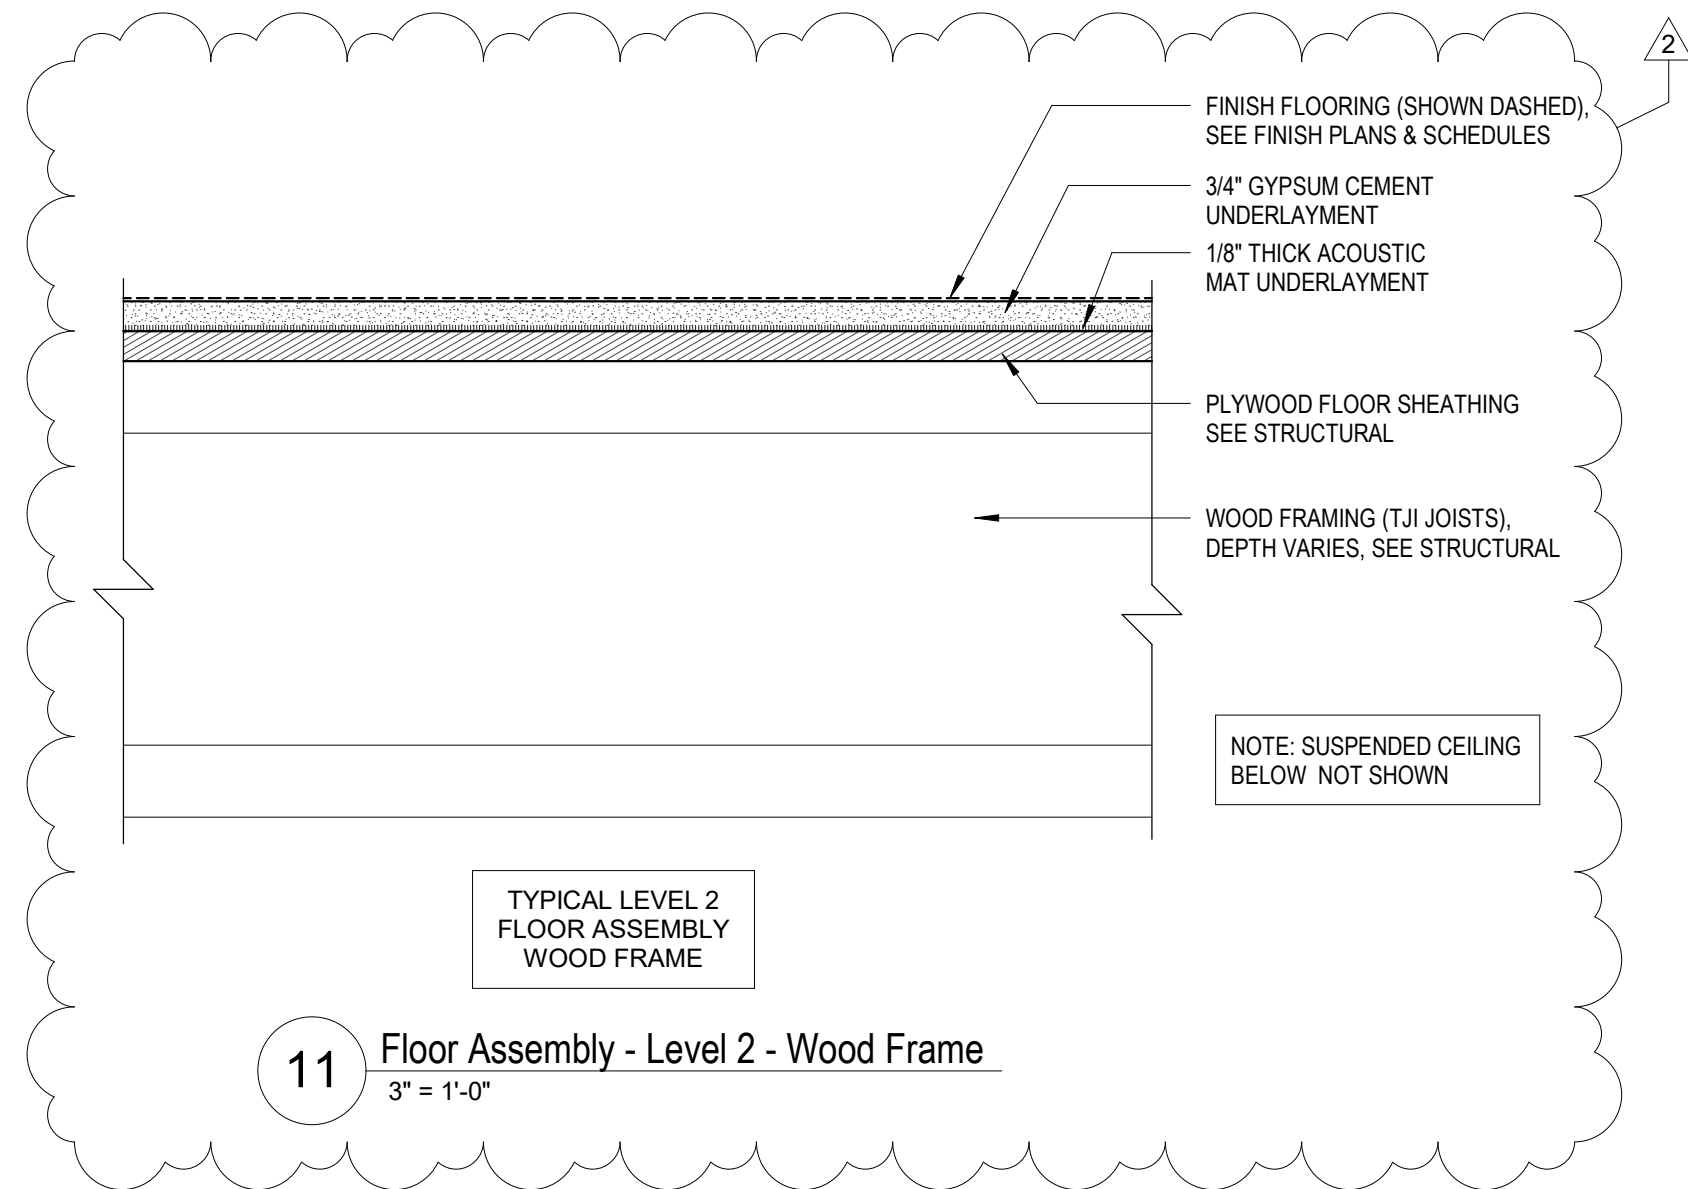


11 Floor Assembly - Level 2 - Wood Frame

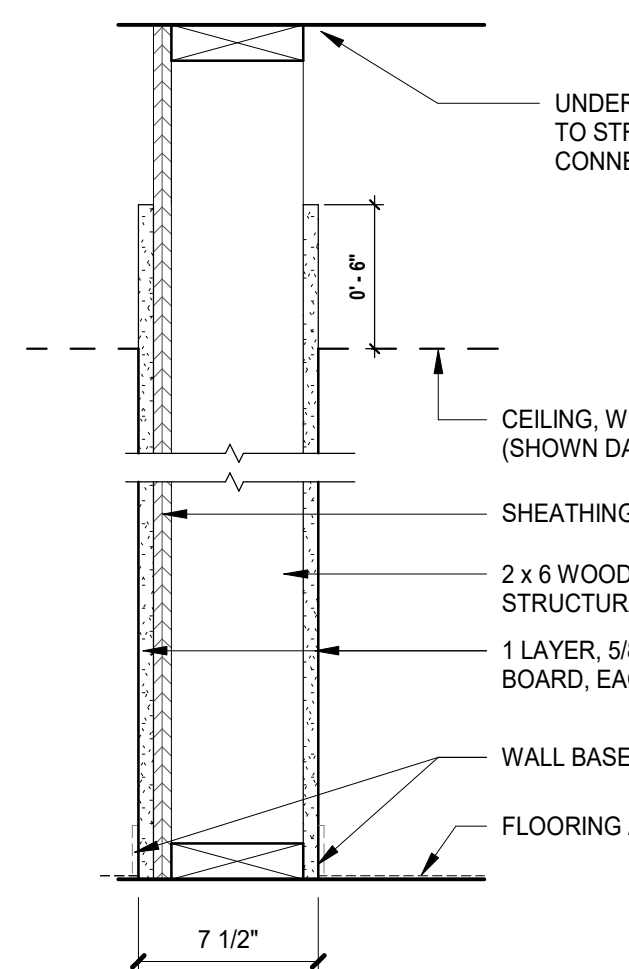


W60-1 Non-Rated Shear Wall

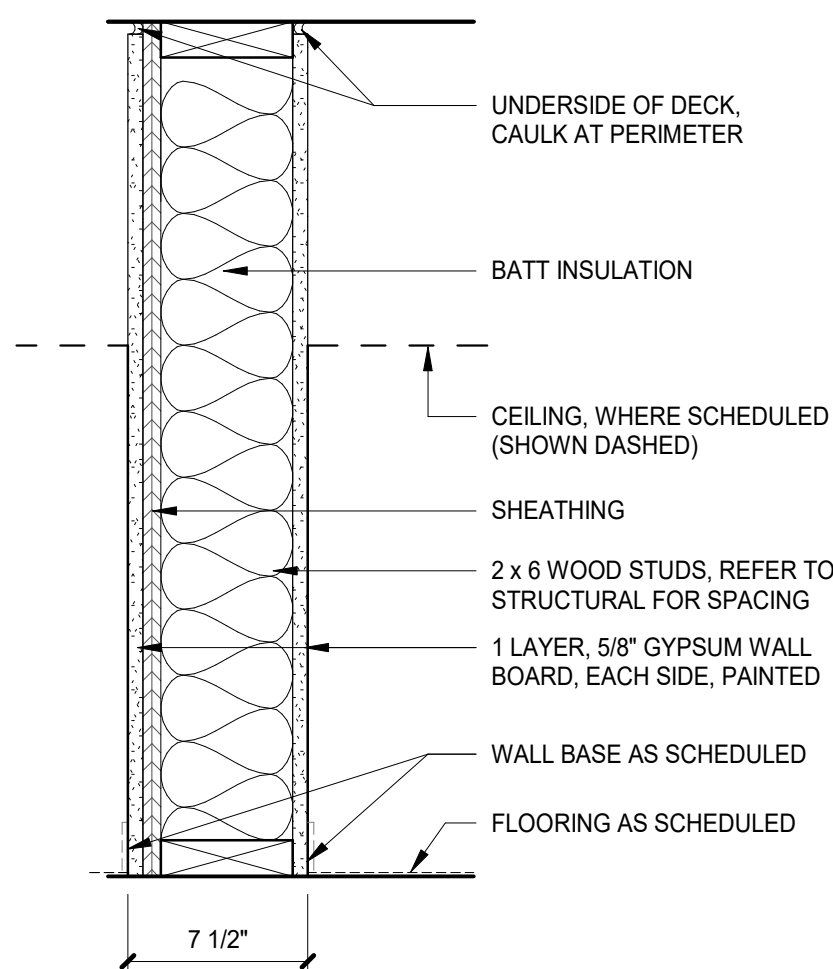


W60-2 Non-Rated Acoustic Shear Wall

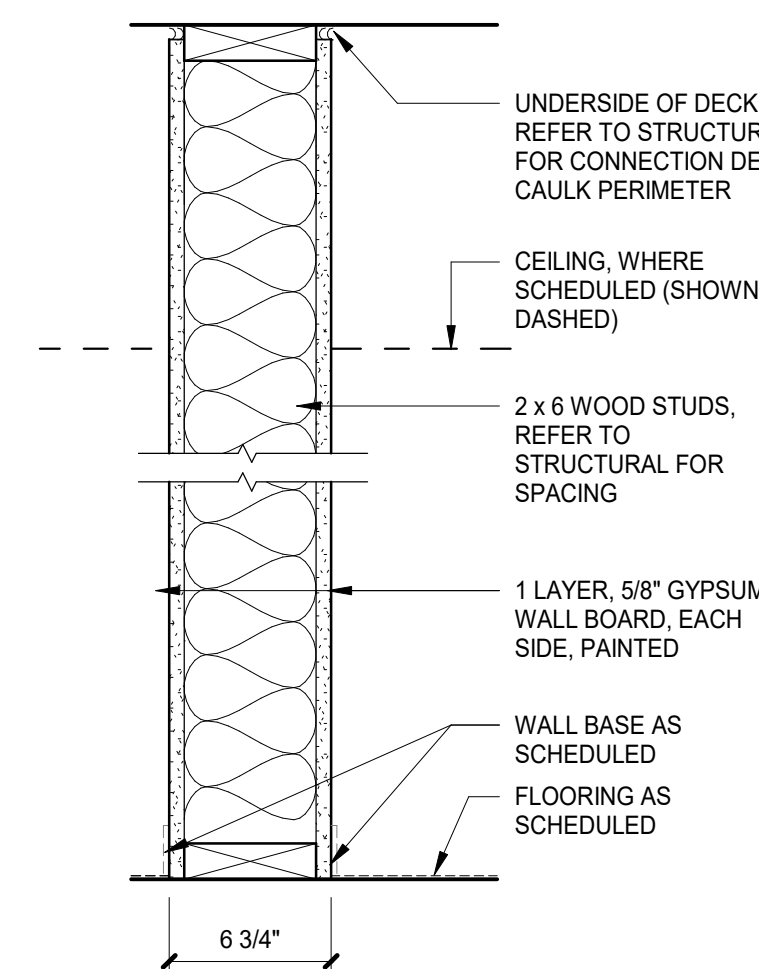


W60-4 Non-Rated Load Bearing Wall

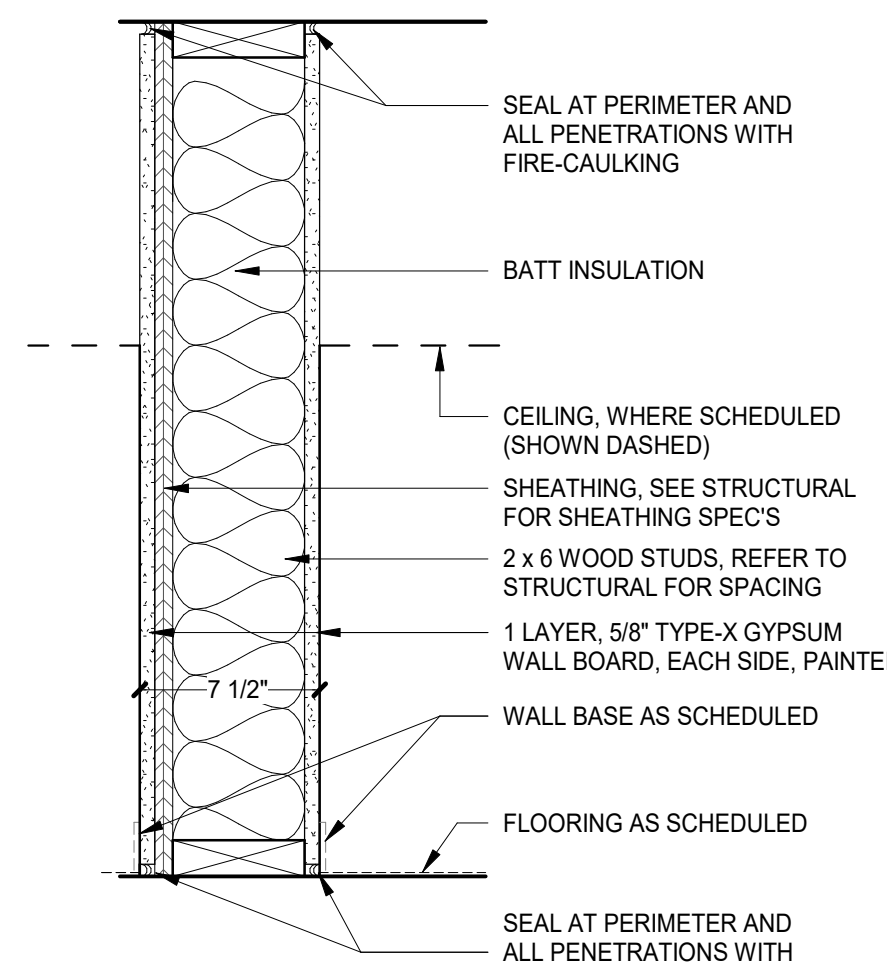


W61-1 1-HR Rated Acoustic Shear Wall

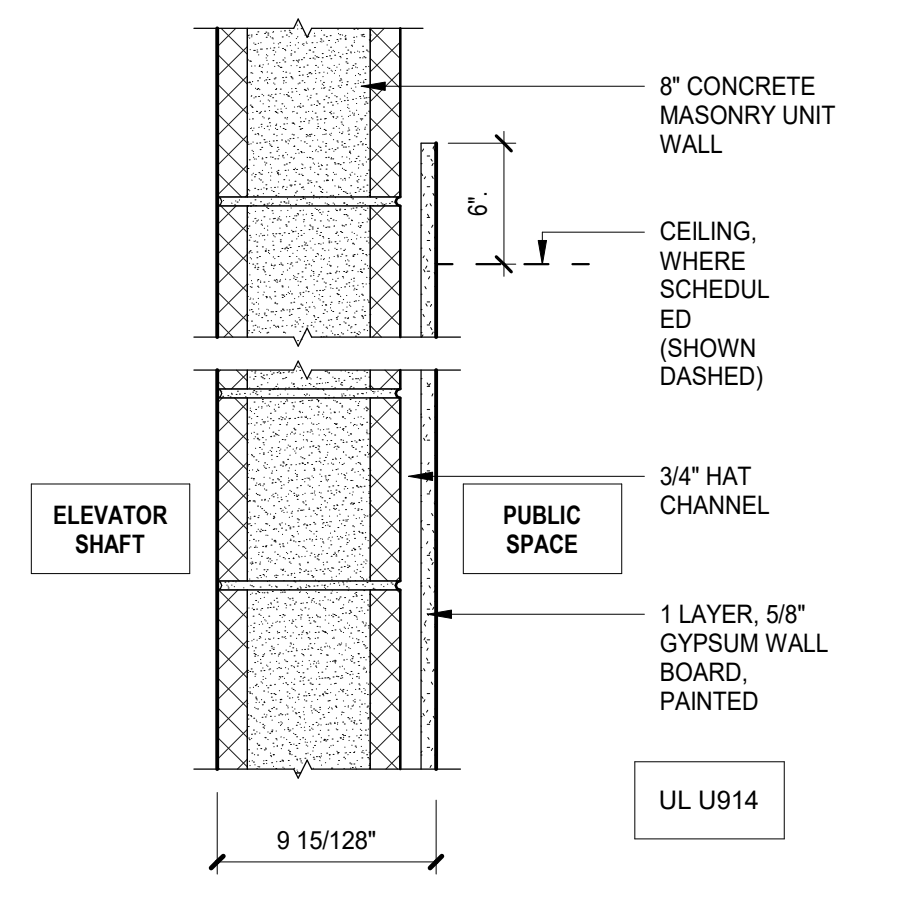


M81-1 1 Hour Rated Elevator Shaft Partition
1 HOUR RATED UL 914 CMU SHAFT

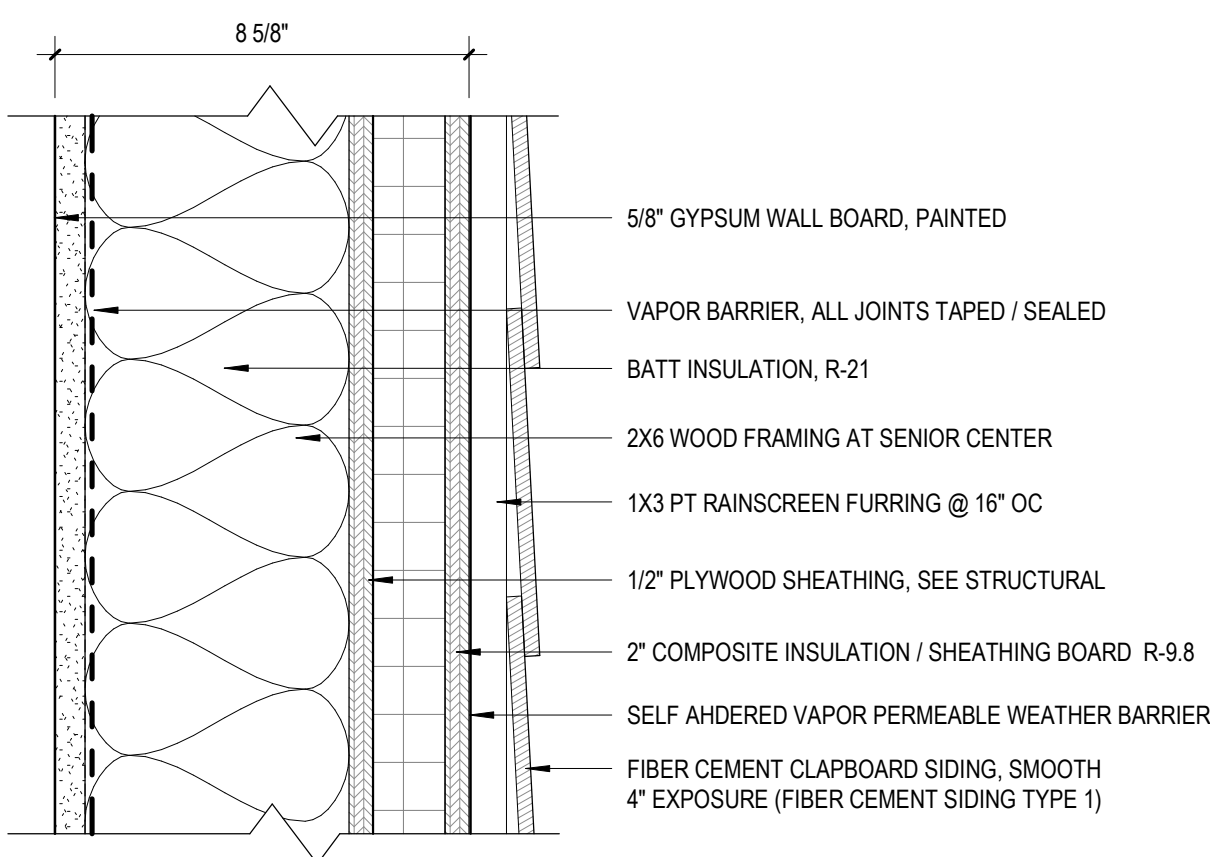


1 Exterior Wall Assembly - EXT-W1 Wood Frame / Clapboard

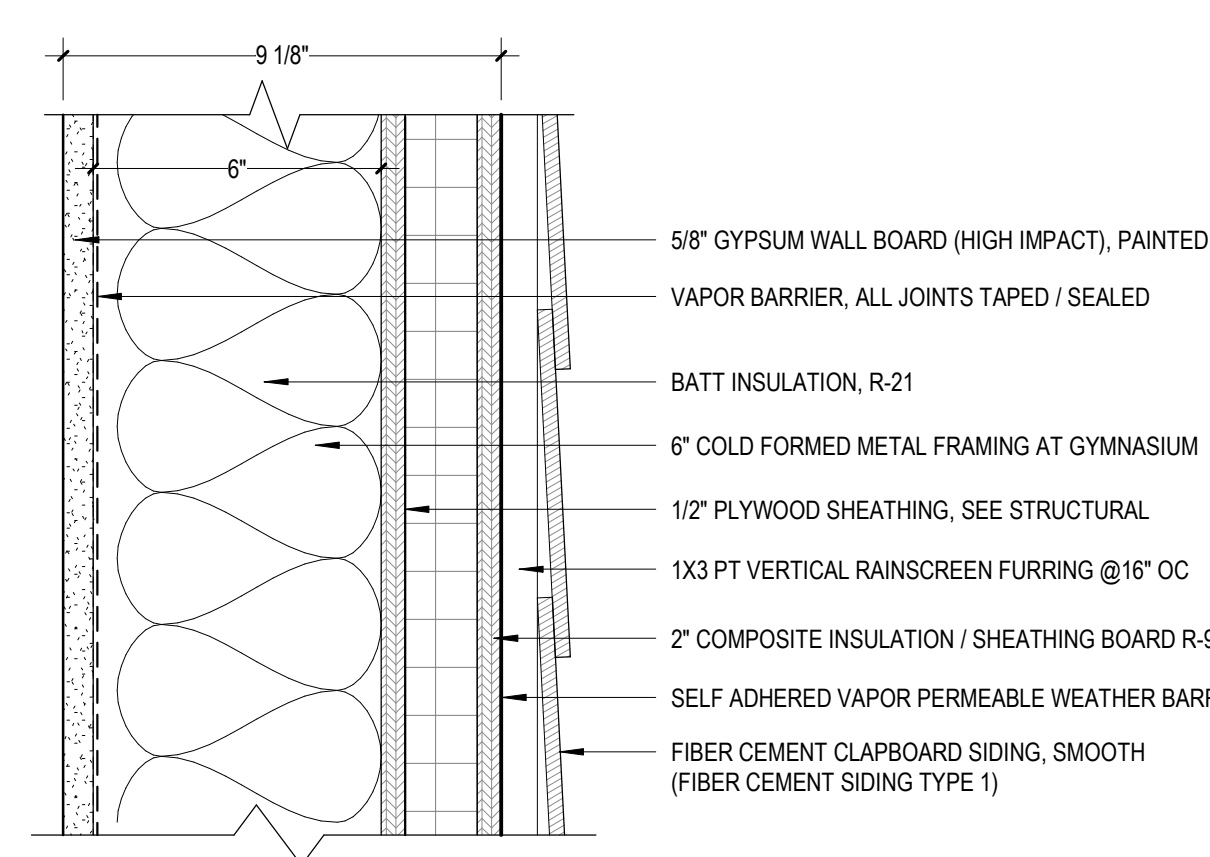


2 Exterior Wall Assembly - EXT-S1 Steel Frame / Clapboard

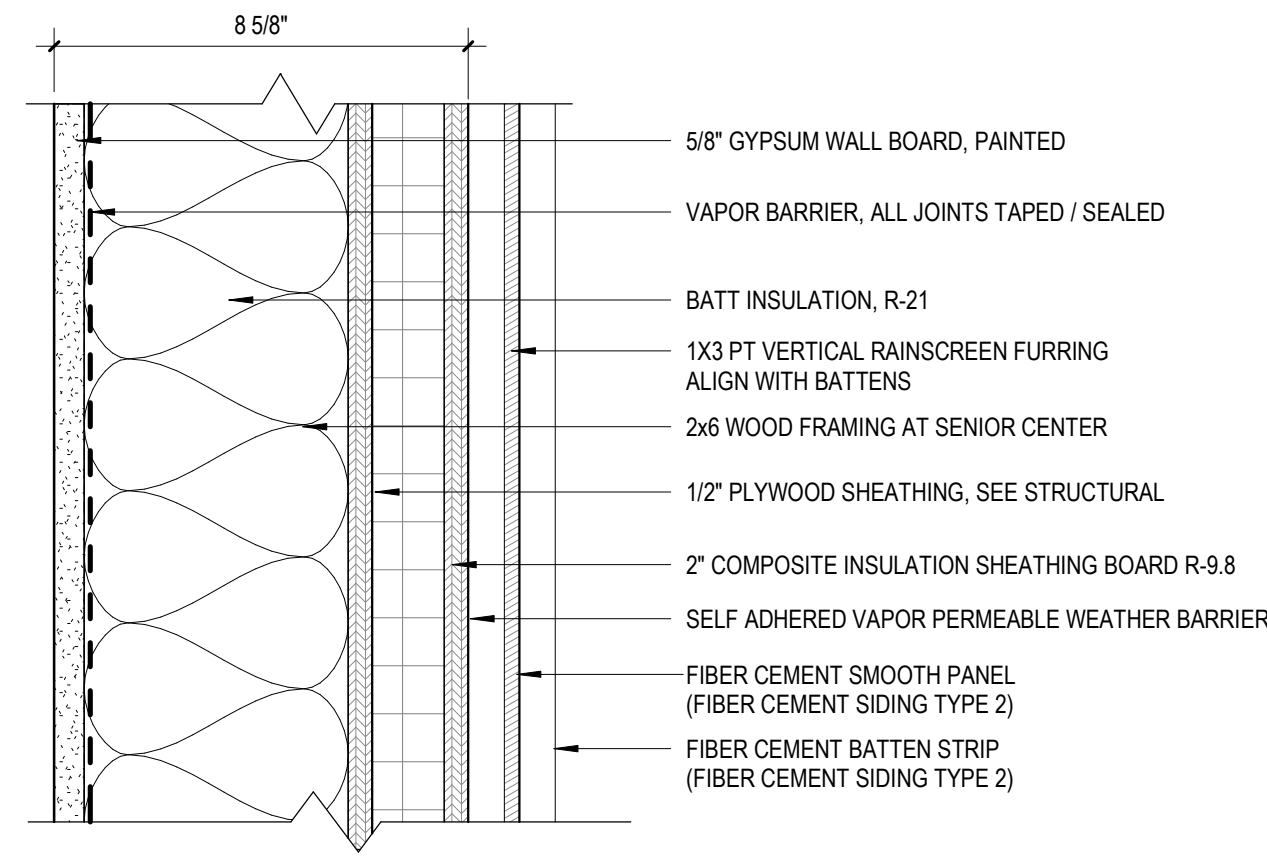


3 Exterior Wall Assembly - EXT-W2 Wood Frame / Fiber Cement Board and Batten

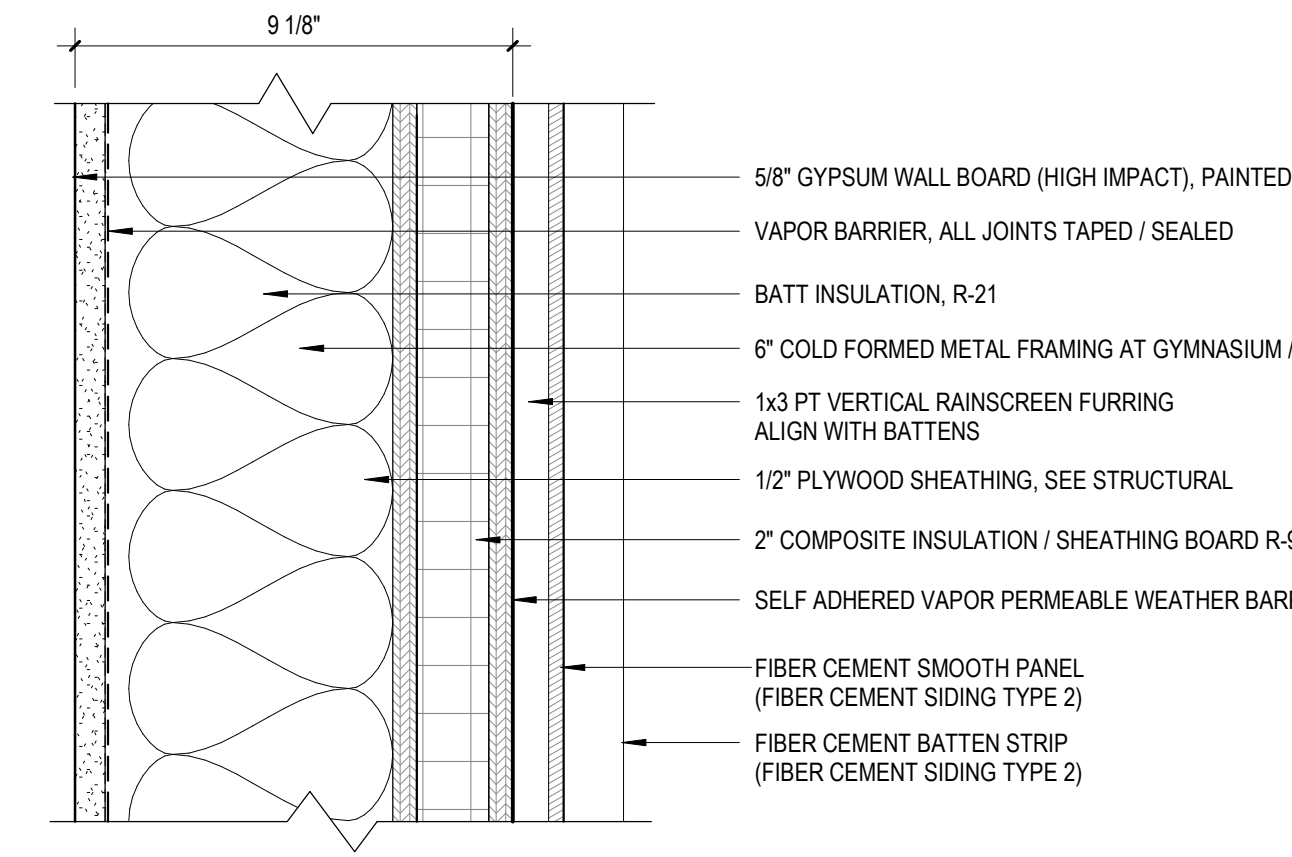


4 Exterior Wall Assembly - EXT-S2 Steel Frame / Fiber Cement Board and Batten

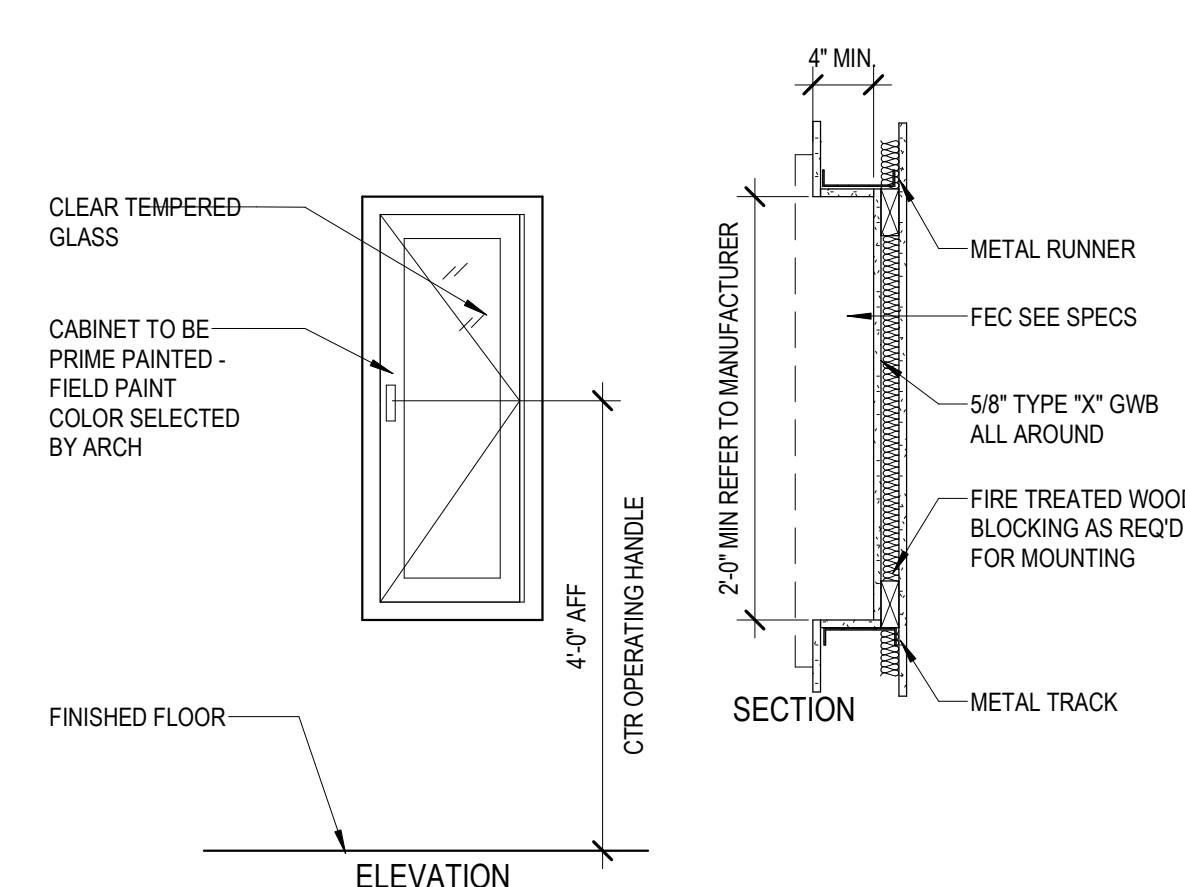


5 FIRE EXTINGUISHER CABINET

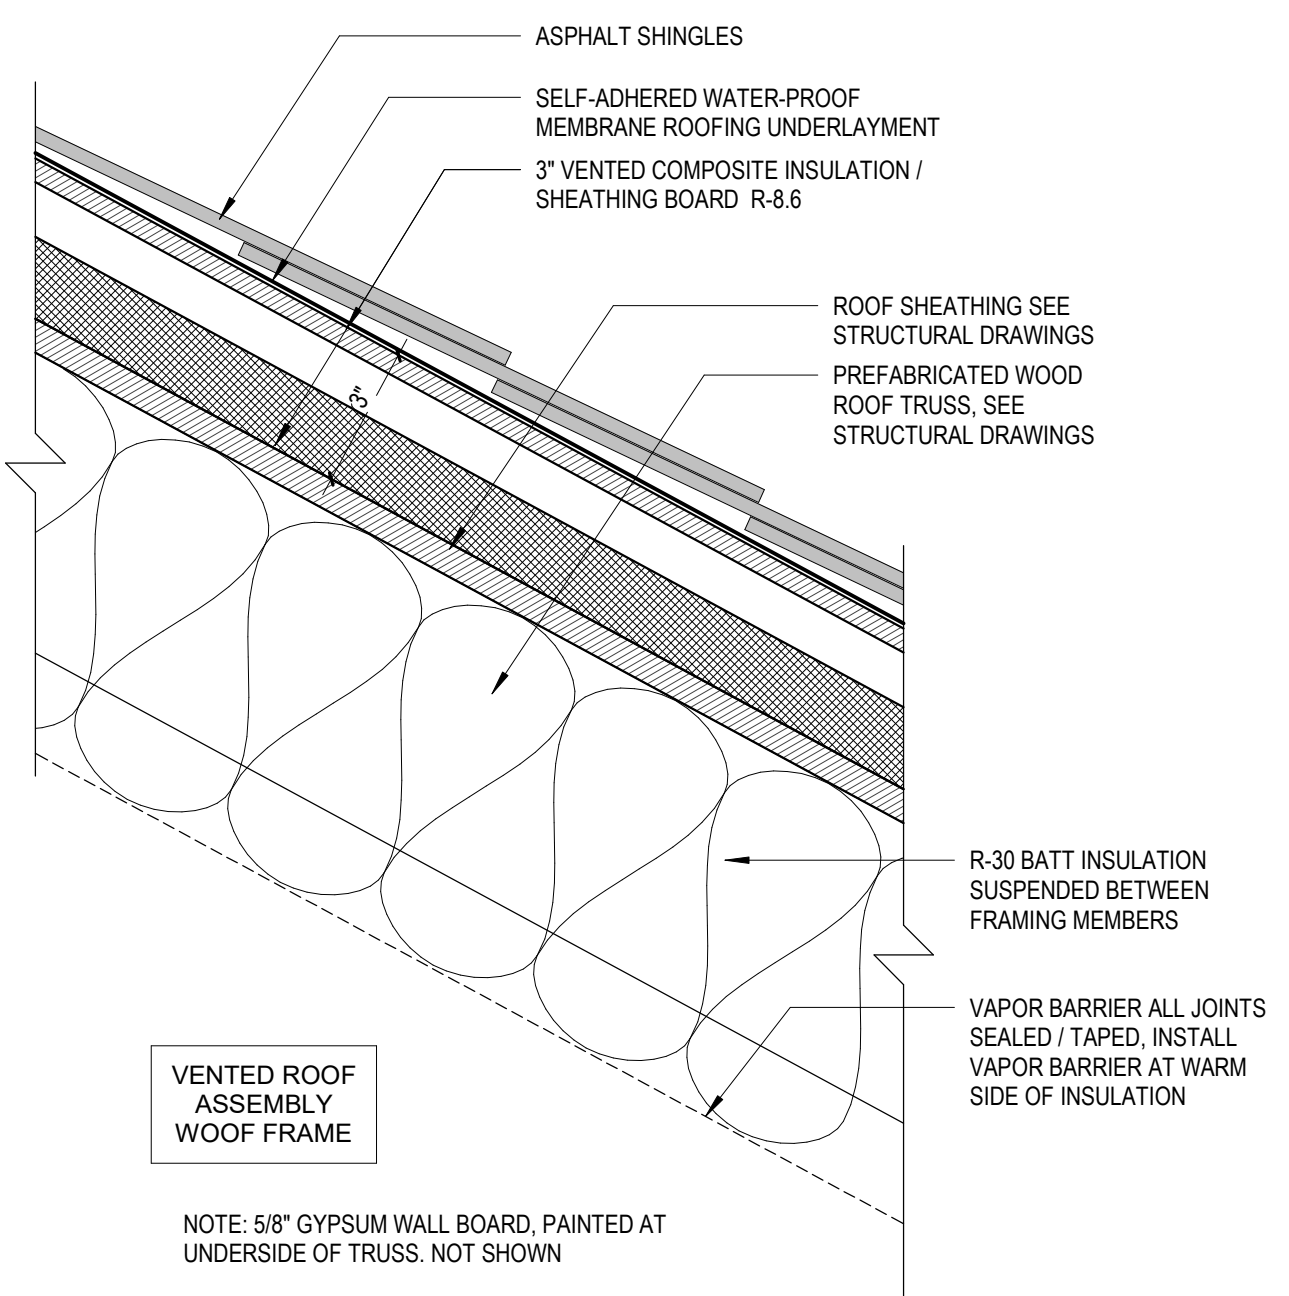


6 Roof Assembly - R-W1 Wood Frame Community Center

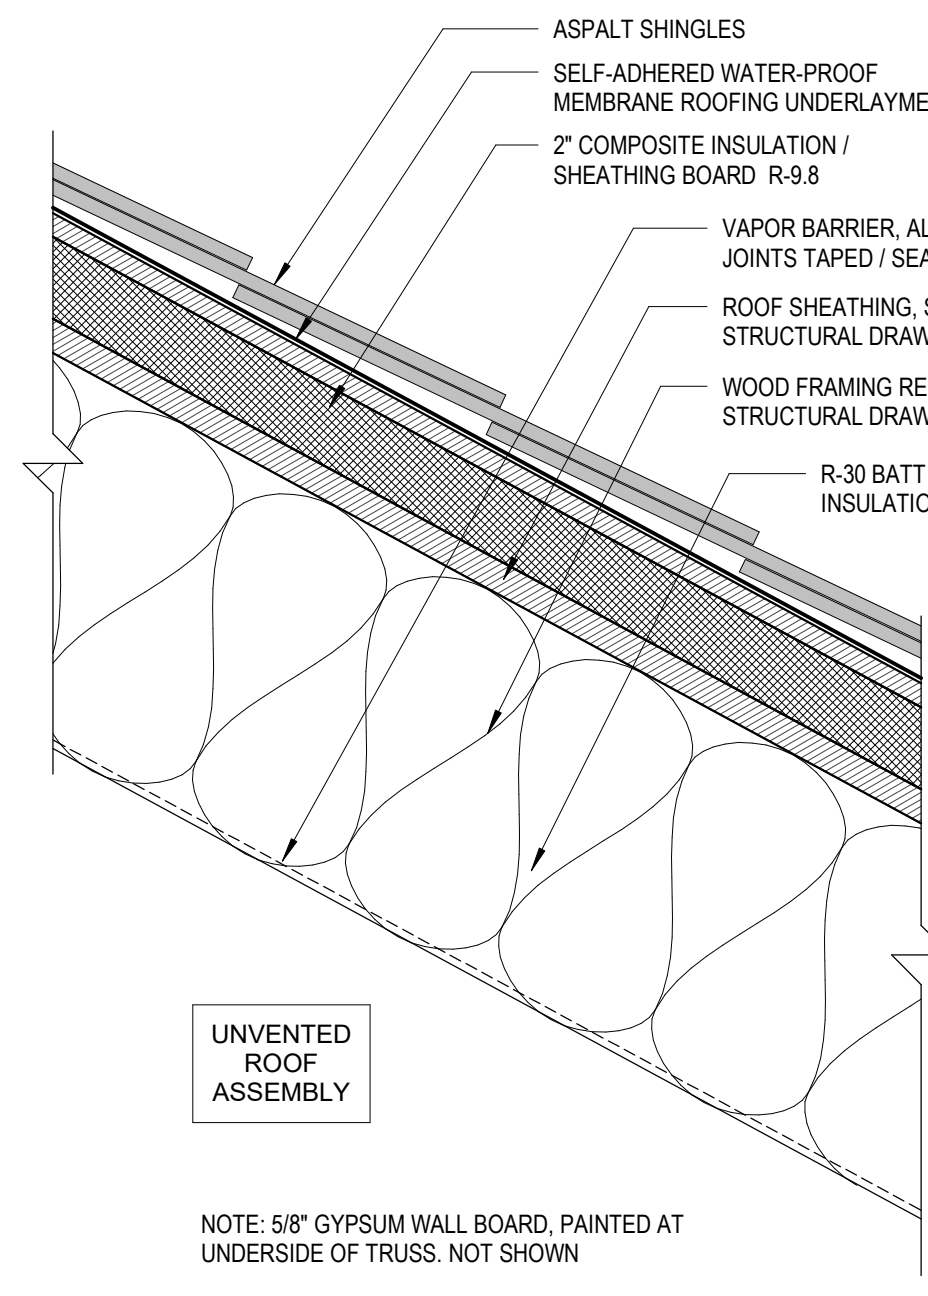


7 Roof Assembly - R-W2 Wood Frame Community Center

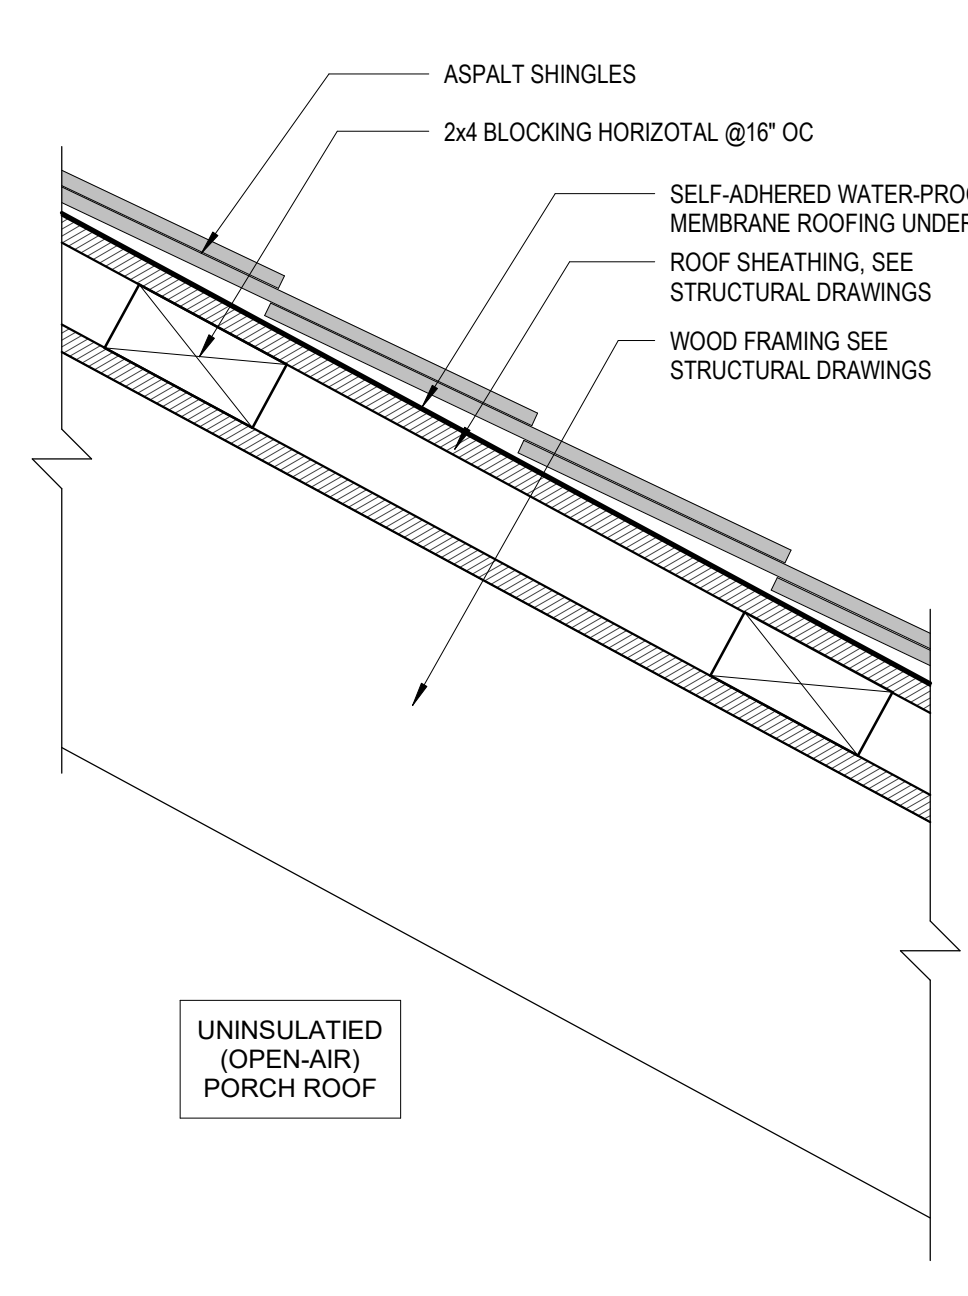

8 Roof Assembly - R-W3 Wood Frame Community Center / Walkway

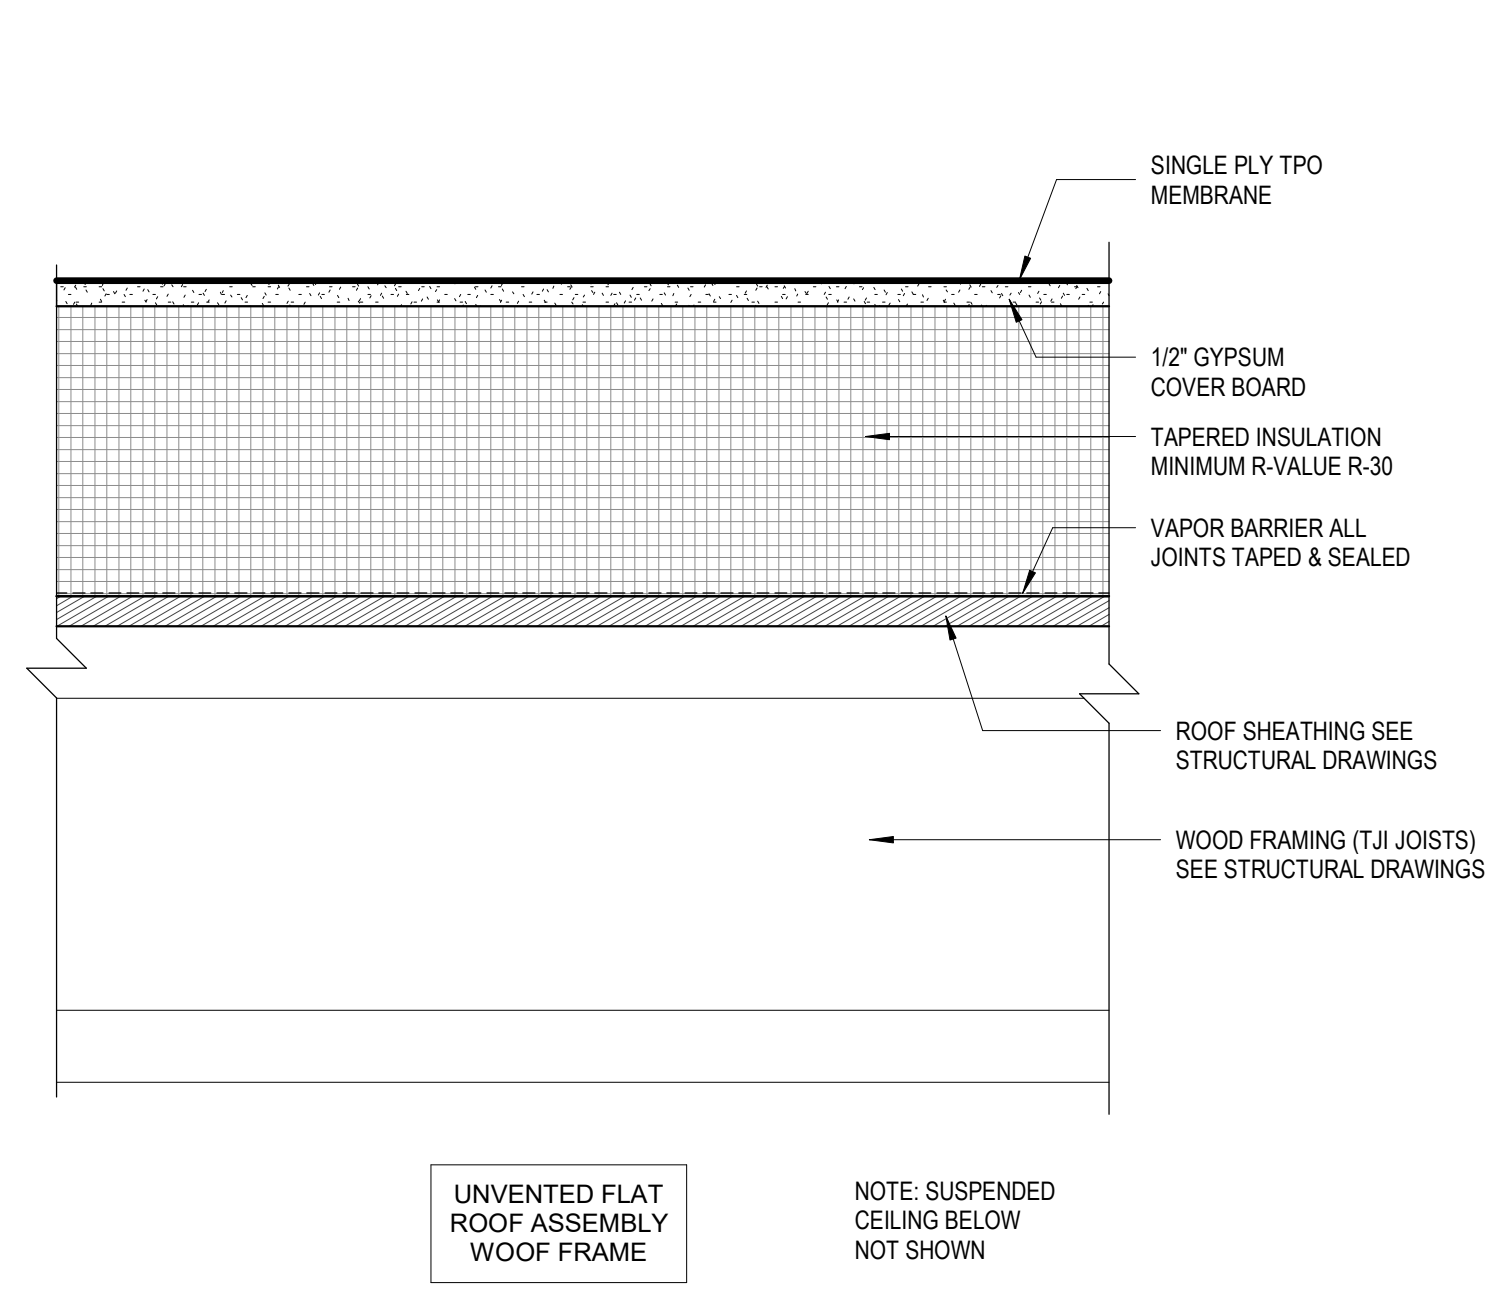

9 Roof Assembly - R-W4 Wood Frame Community Center (Flat)

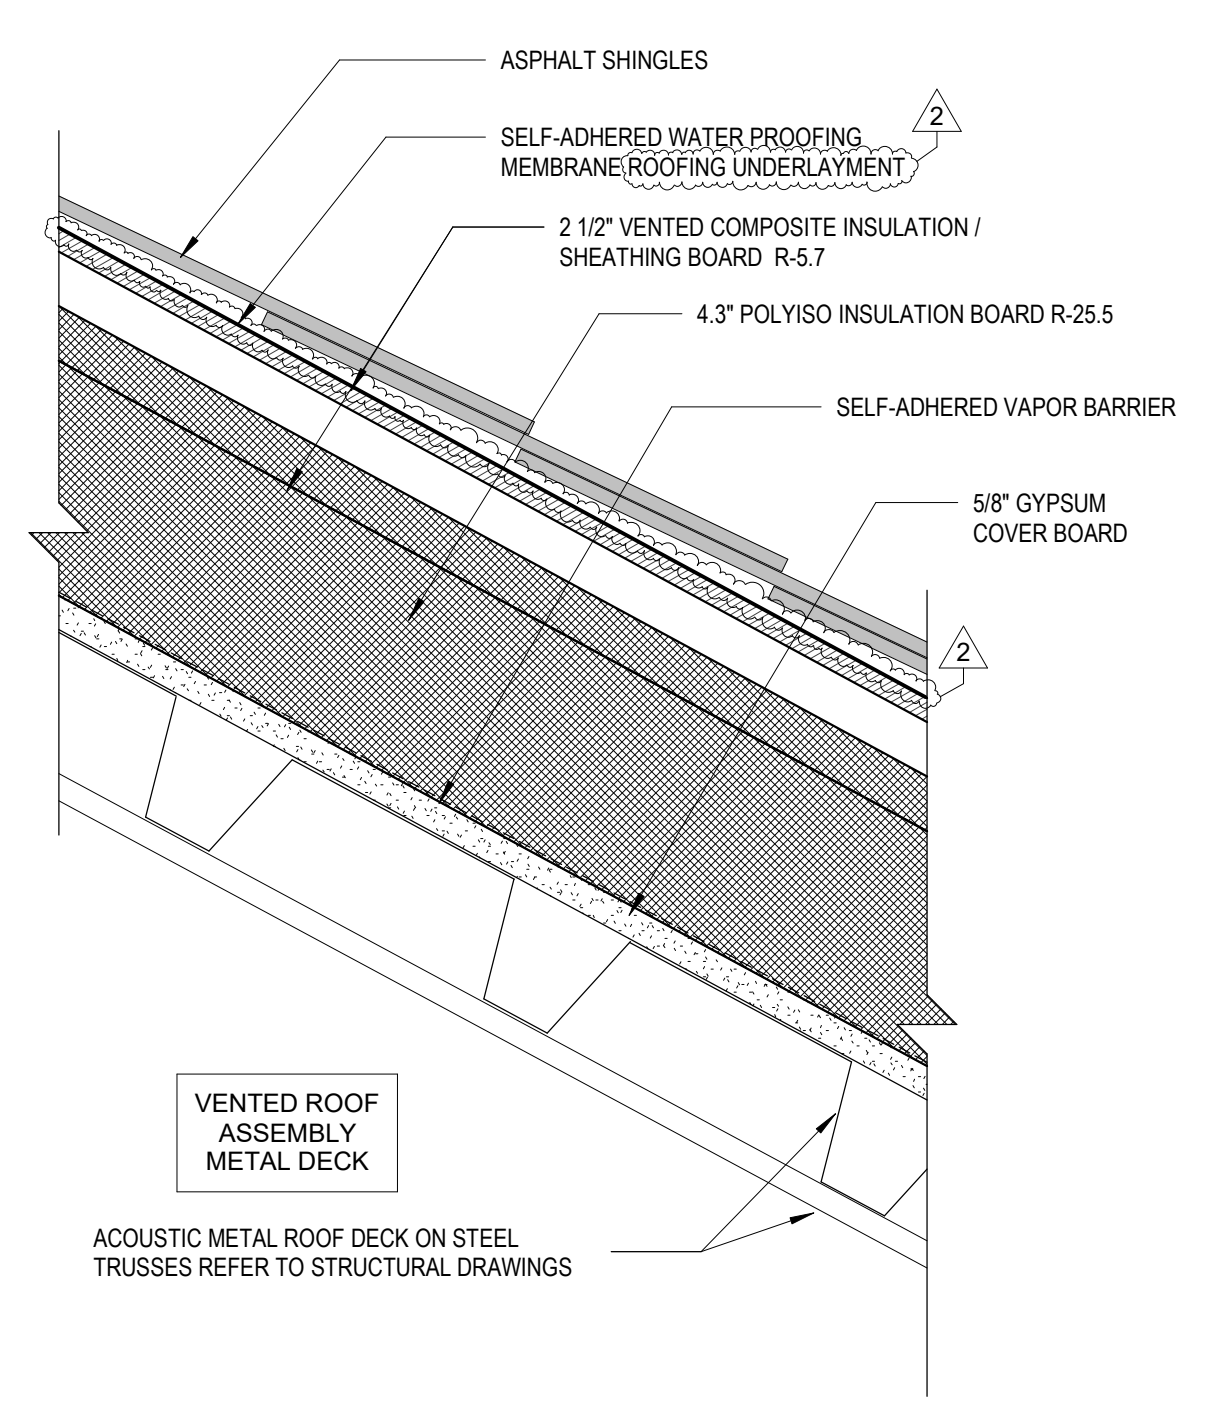


10 Roof Assembly - R-S1 Steel Frame Gym

REVISIONS		
2	Addendum #2	08/03/2022


DRAWING TITLE
Partition Types and Exterior Assemblies

DRAWING INFORMATION		
07/22/22	DATE OF ISSUE	
Construction Documents	DESCRIPTION	
As indicated	SCALE	GDALY
3403.00	PROJECT #	


DRAWING NUMBER
A002

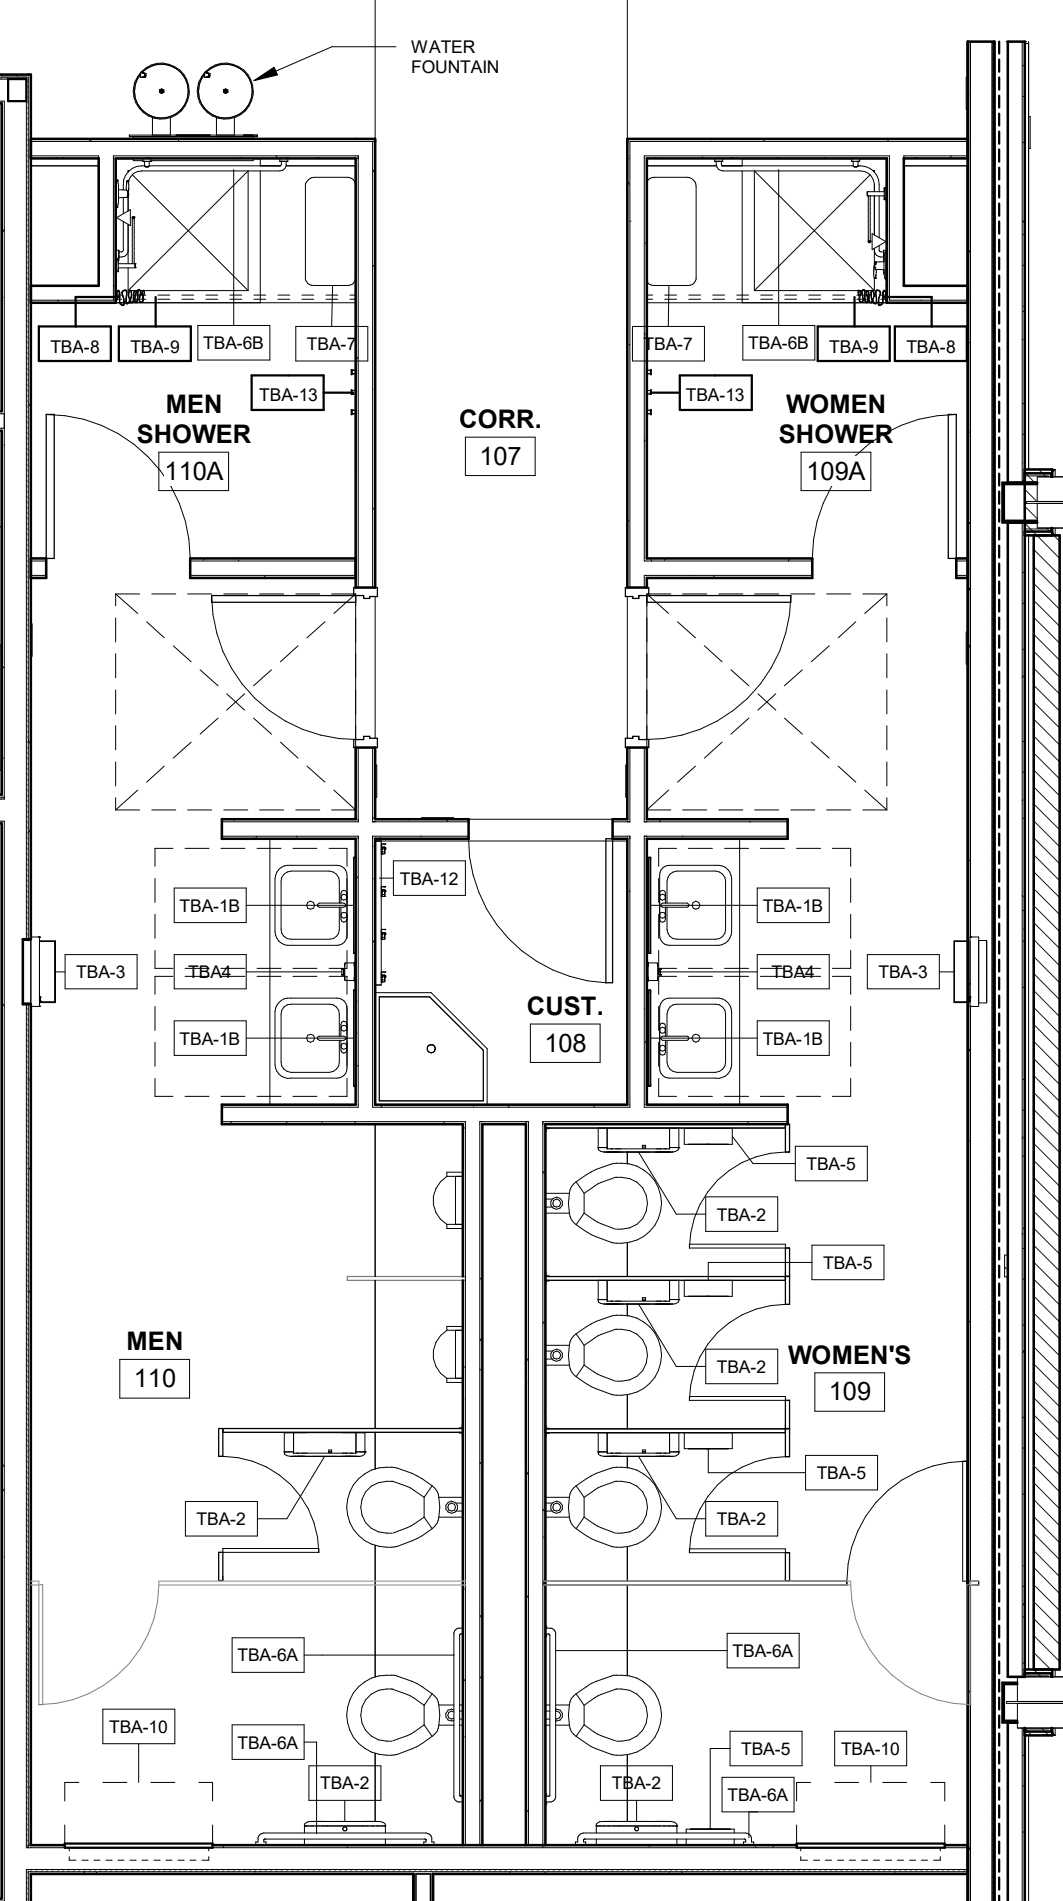


A1 FIRST FLOOR BATHROOM PLAN - TOILET ACCESSORIES
1/4" = 1'-0"

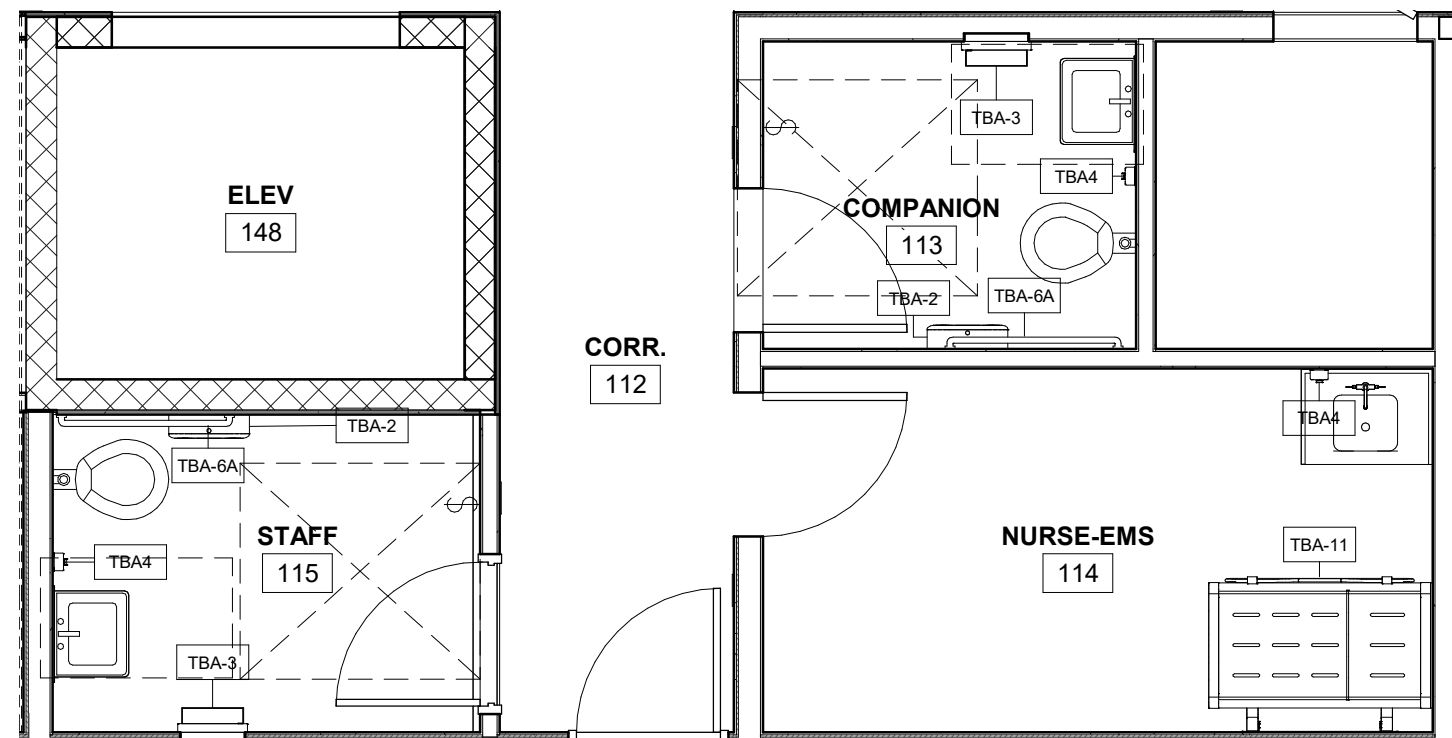


A2 STAFF BATHROOM PLAN - TOILET ACCESSORIES
1/4" = 1'-0"

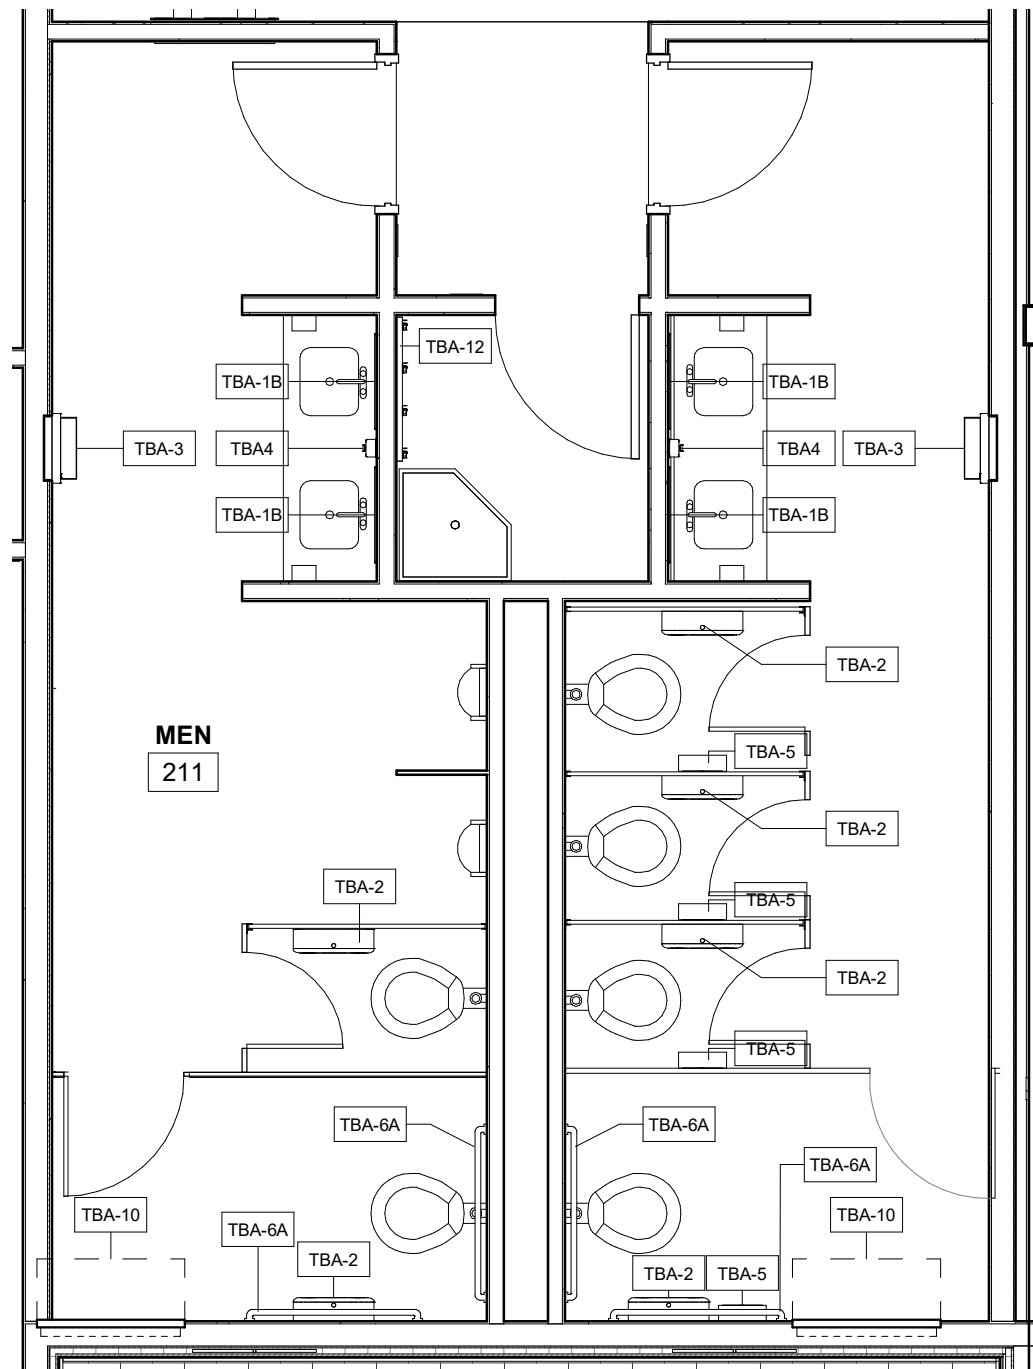

A3 SECOND FLOOR BATHROOM PLAN - TOILET ACCESSORIES
1/4" = 1'-0"

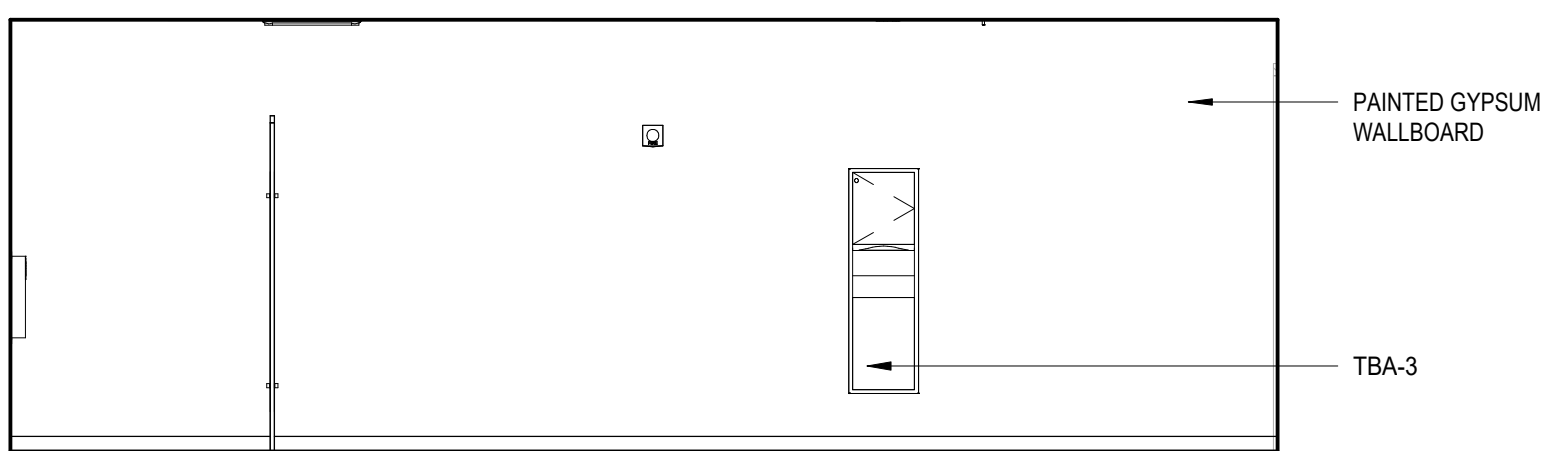


1D MEN ELEVATION D

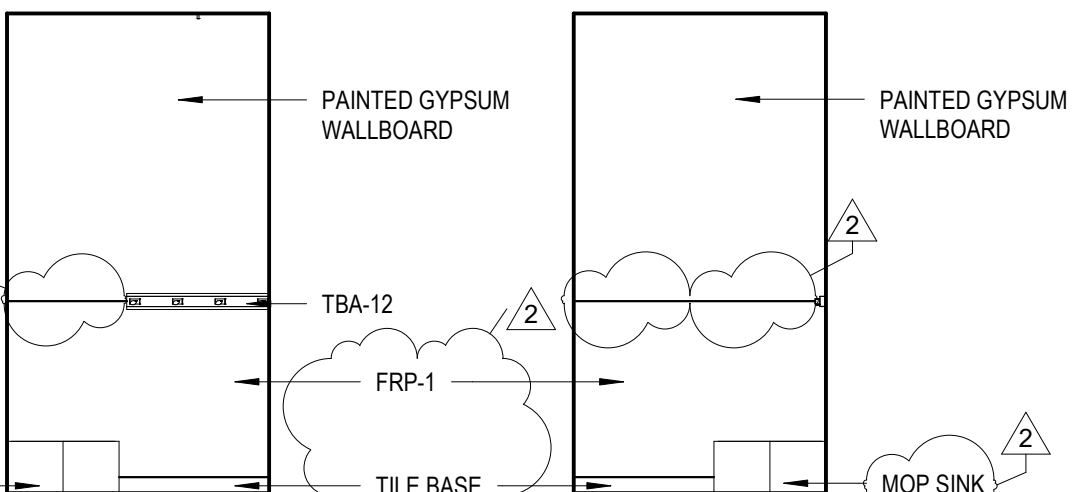


11 CUSTODIAN ELEVATION B
1/4" = 1'-0"

1K MEN'S SHOWER ELEVATION D
1/4" = 1'-0"

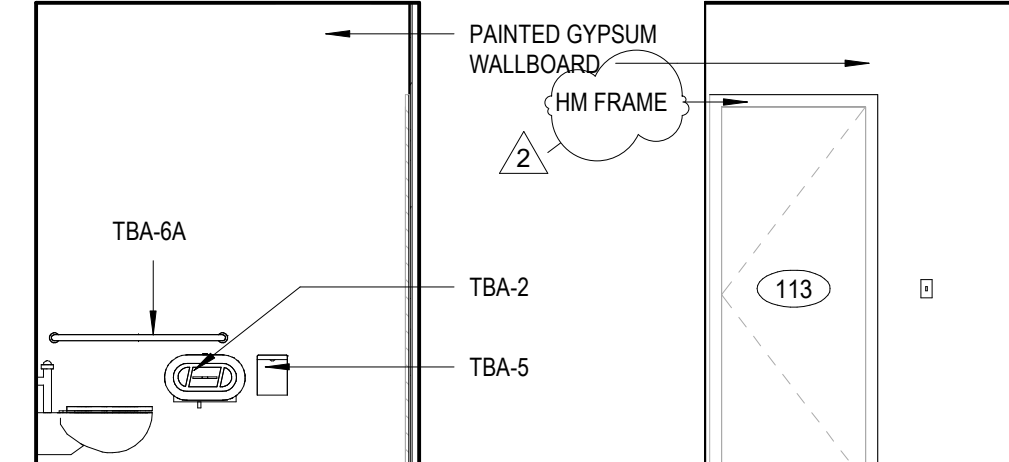


2D COMP. ELEVATION D

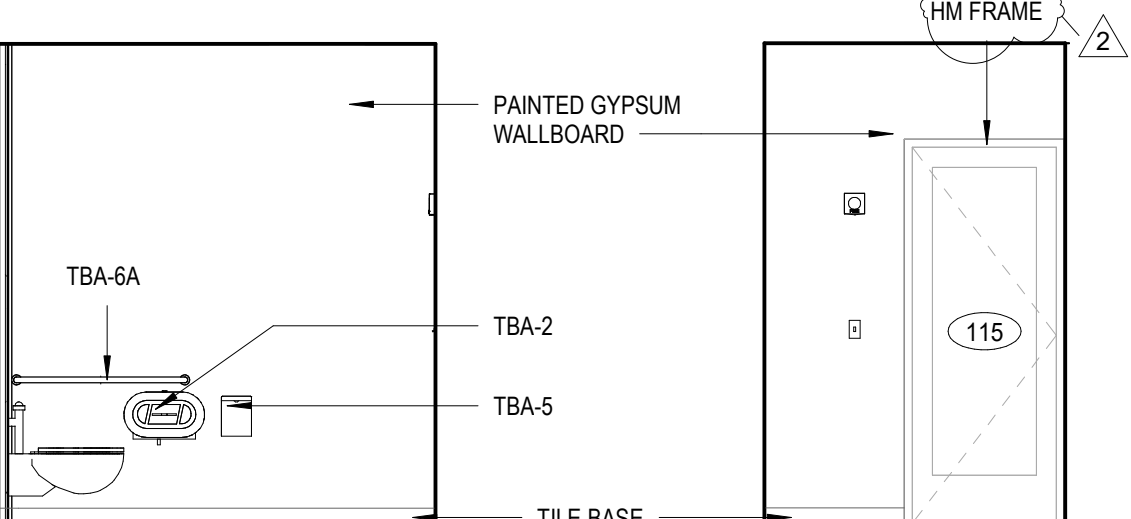


2H STAFF ELEVATION H


NOTE:
REFER TO A700 FOR ROOM FINISH SCHEDULE & LEGEND

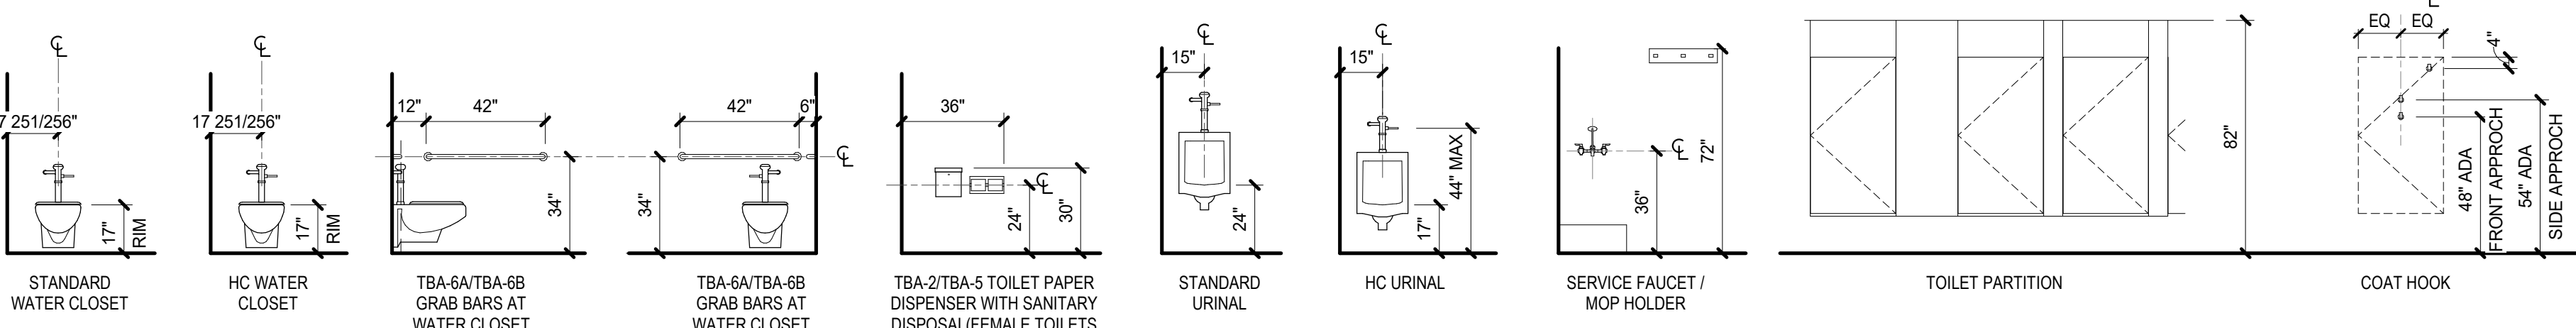

4 TYPICAL MOUNTING HEIGHT
1/4" = 1'-0"

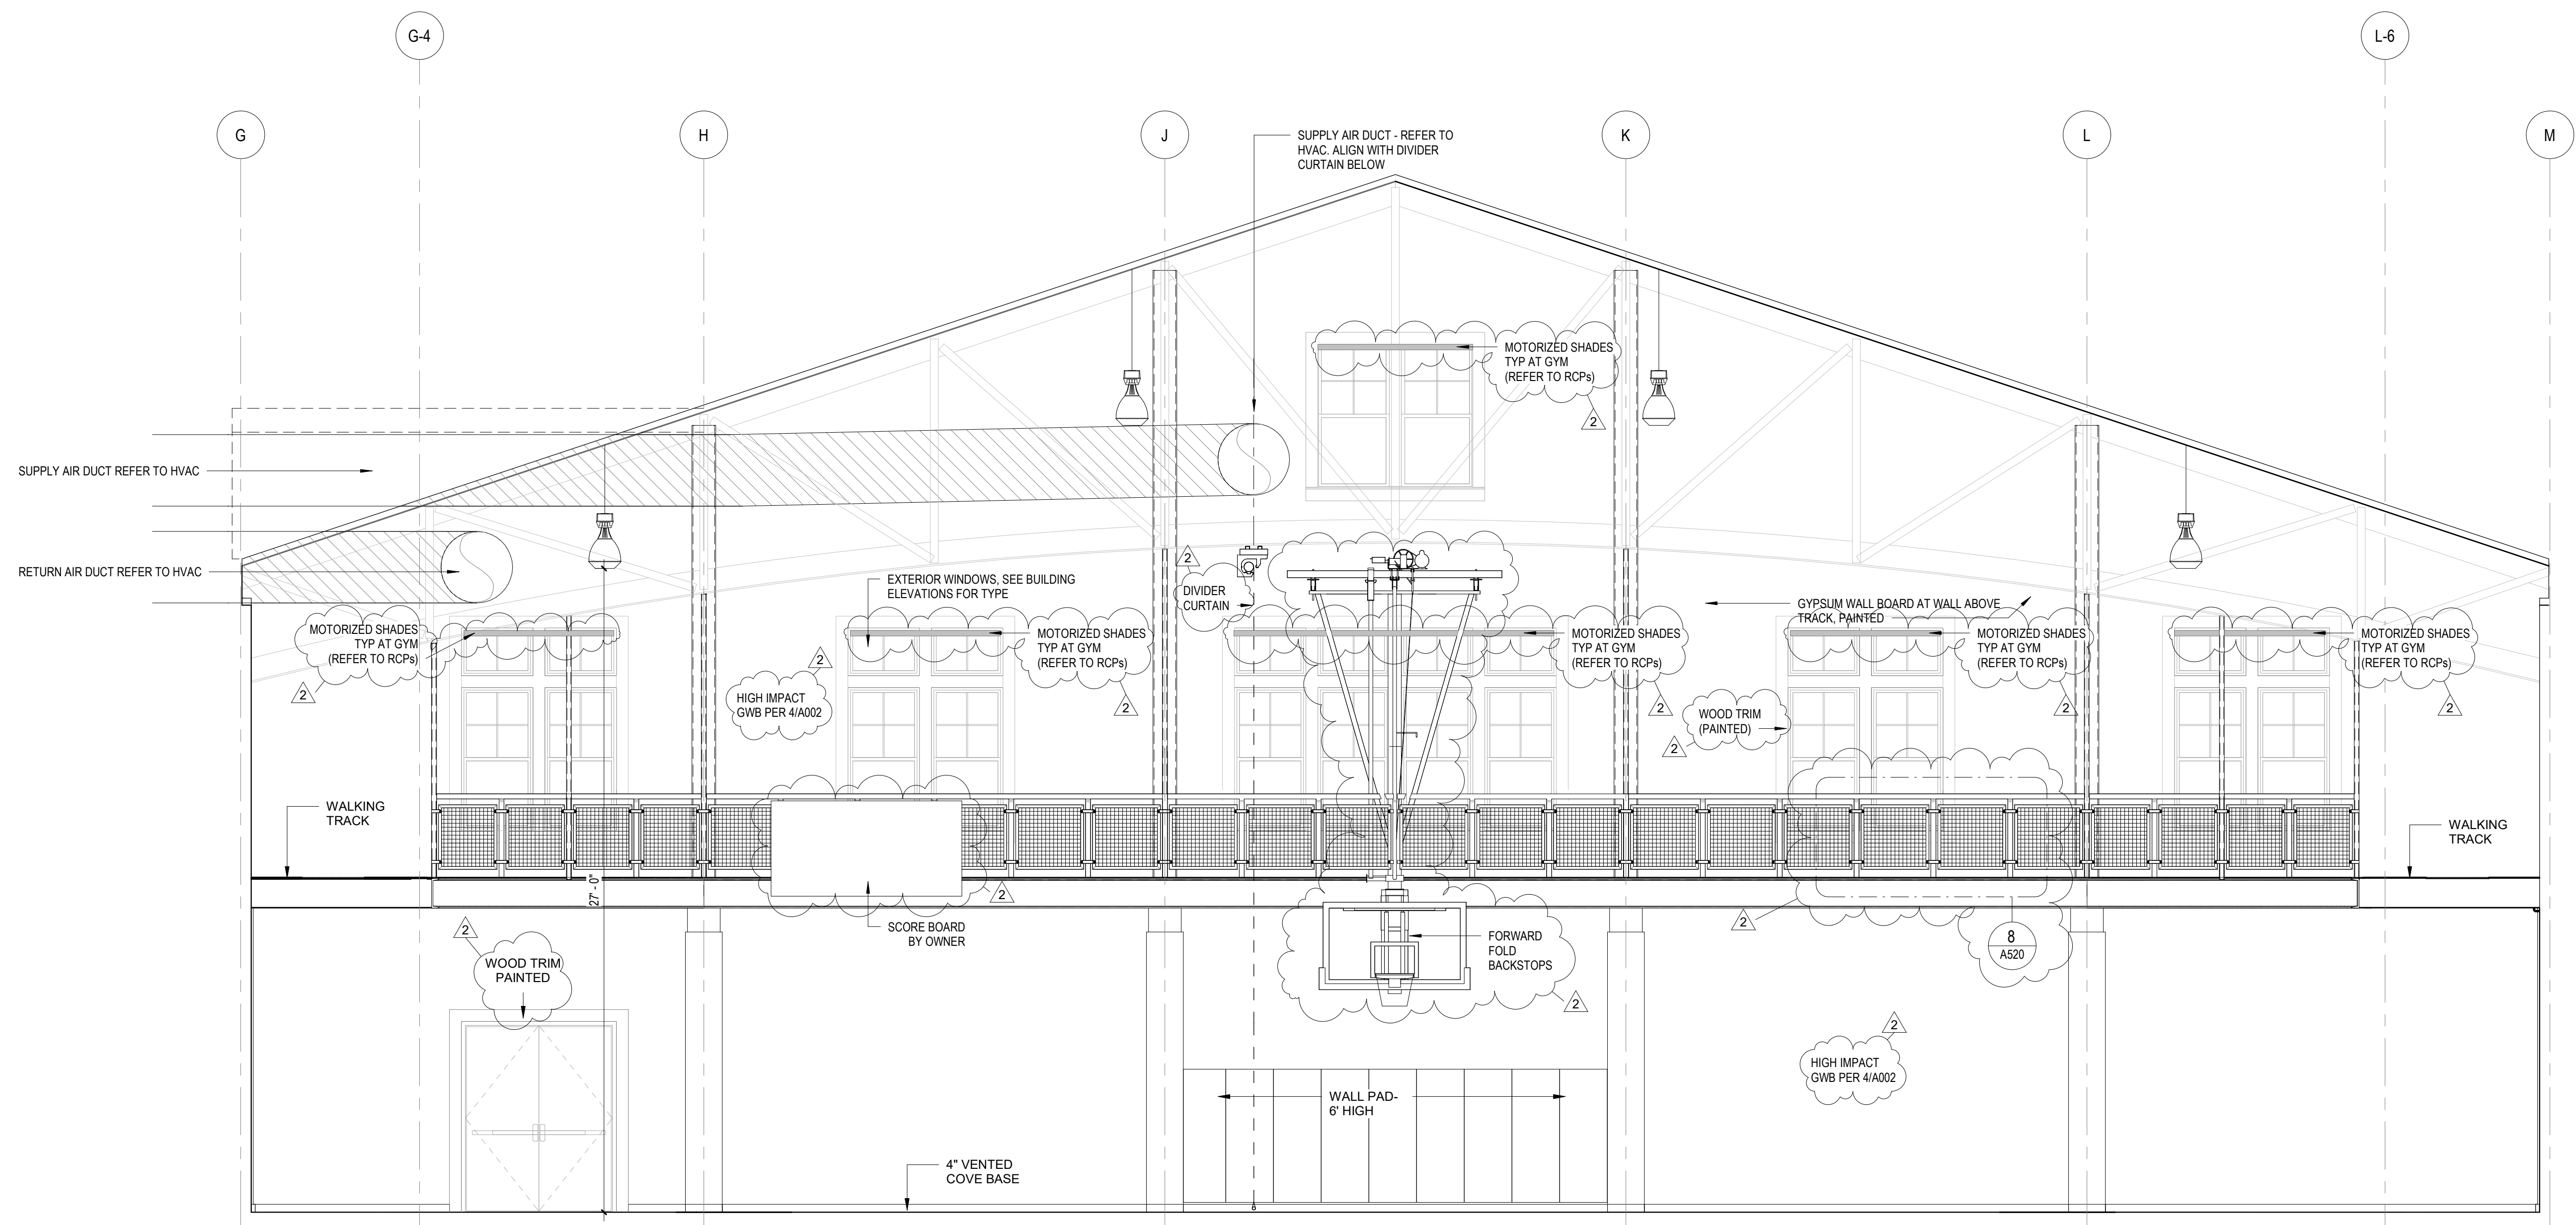

1 DETAIL GUARD RAIL
1/4" = 1'-0"

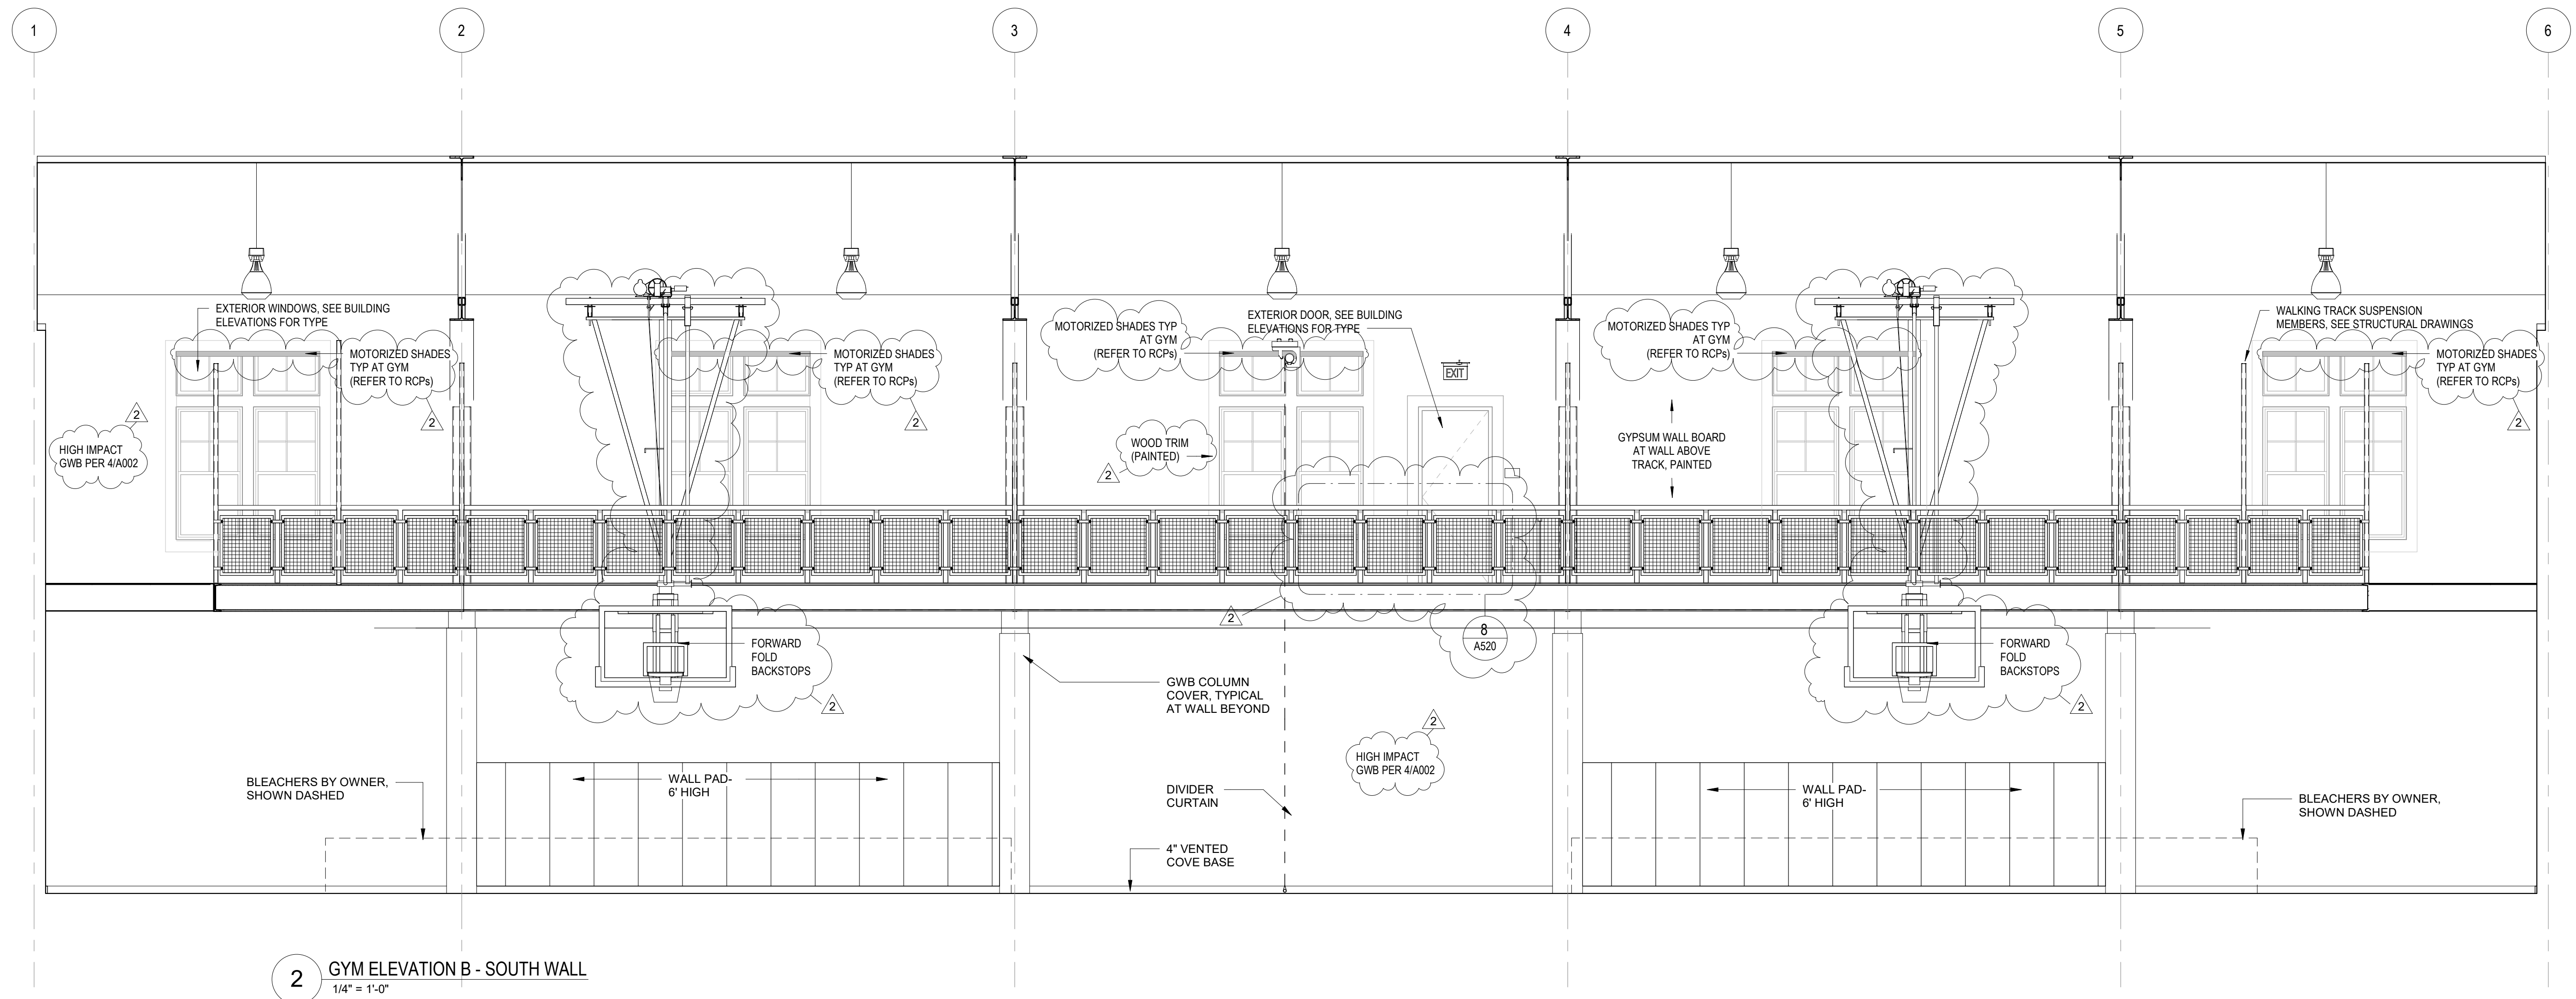

2 GYM ELEVATION B - SOUTH WALL
1/4" = 1'-0"


REVISIONS	
2 Addendum #2	08/03/2022









DRAWING TITLE
Gym Elevations


DRAWING INFORMATION	
07/22/22	DATE OF ISSUE
Construction Documents	DESCRIPTION
1/4" = 1'-0"	SCALE
Author	DRAWN BY
3403.00	PERIOD
PROJECT #	FILE NAME

DRAWING NUMBER


A504

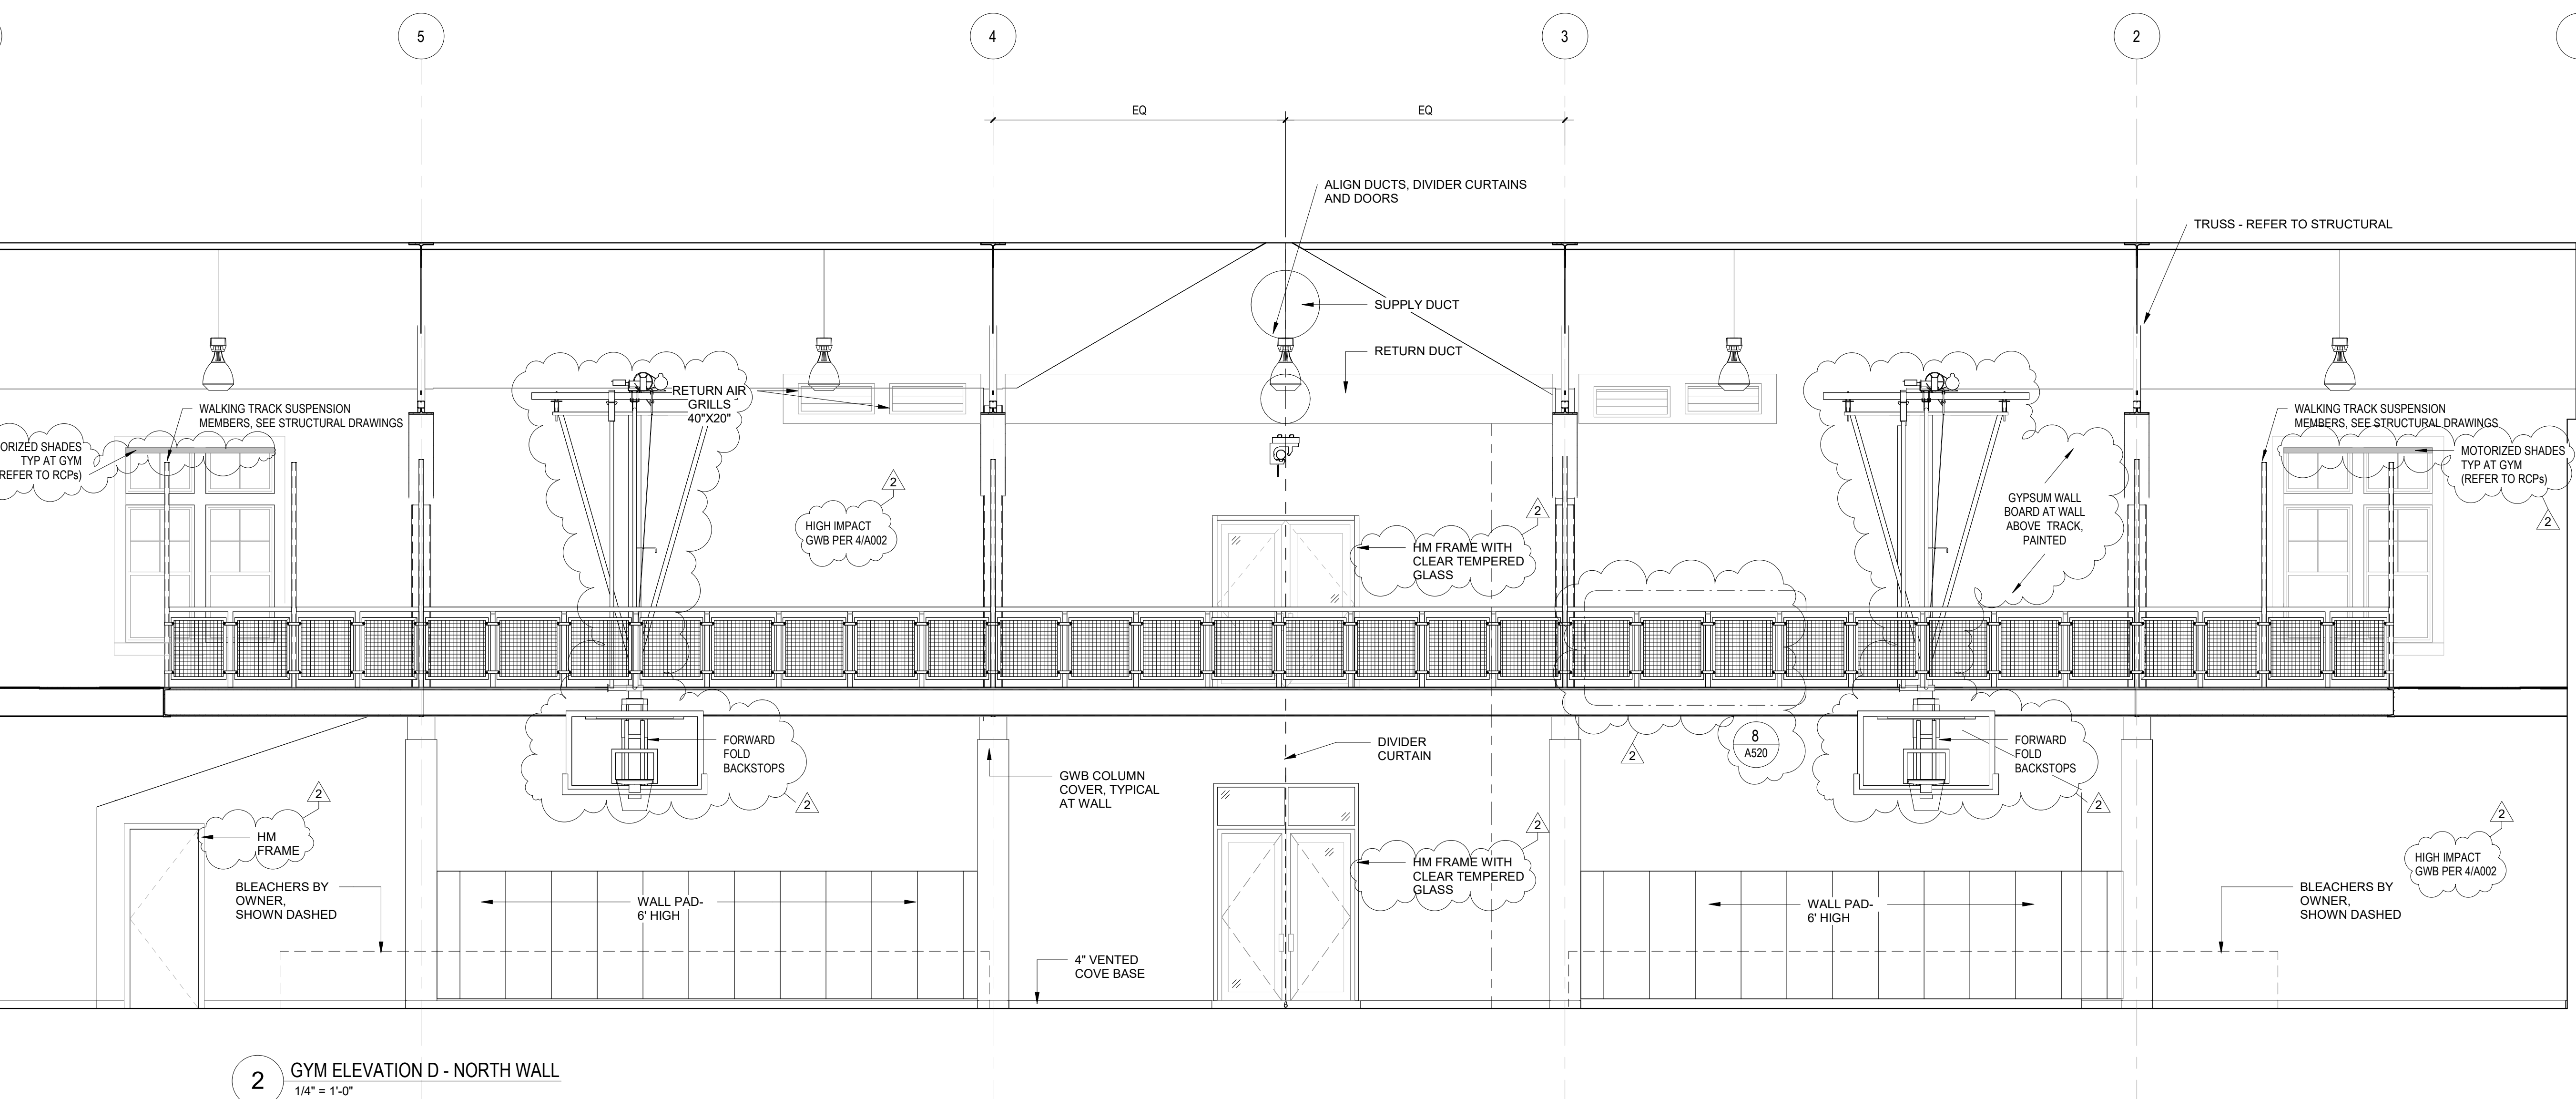

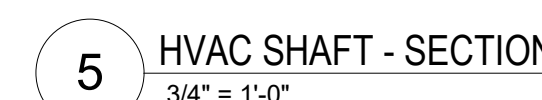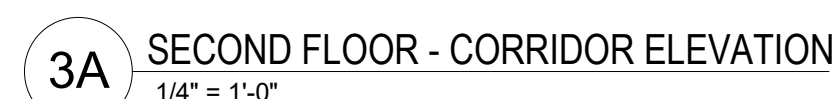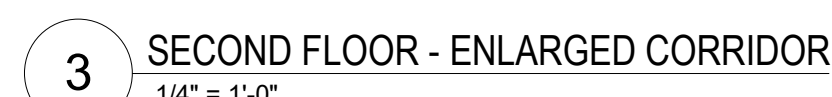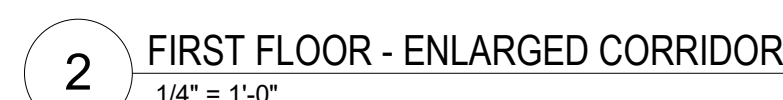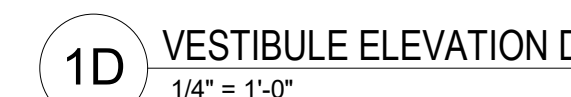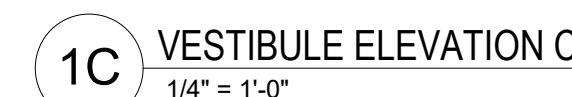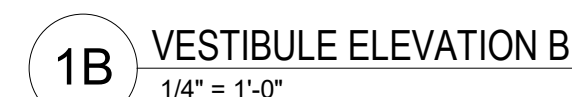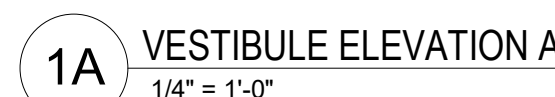


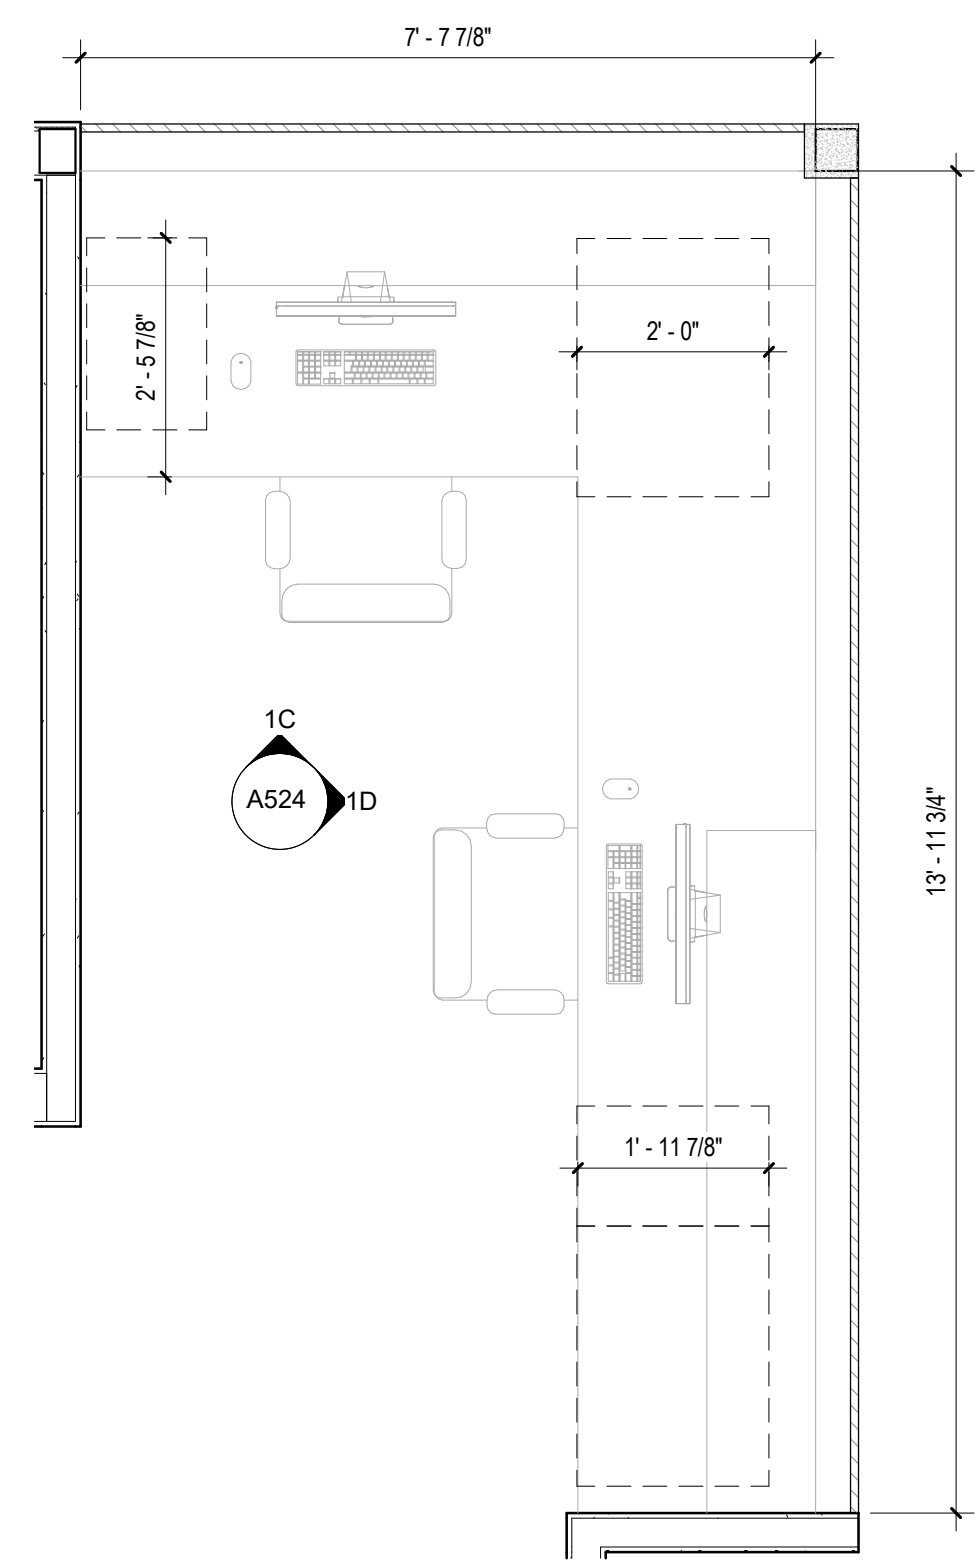


1 FIRST FLOOR RECEPTION
1/2" = 1'-0"

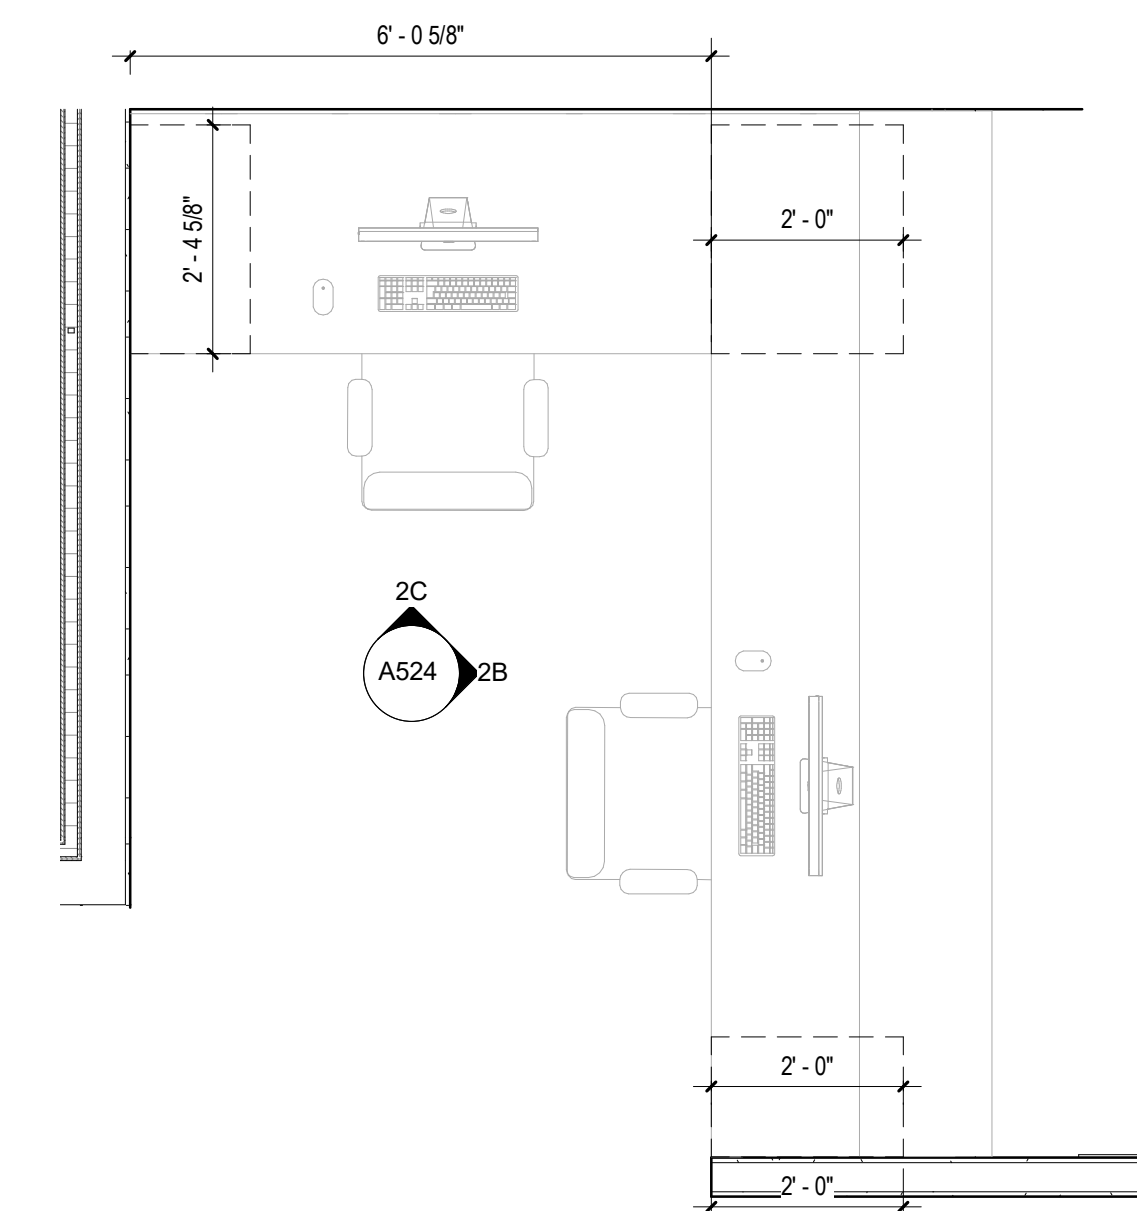


2 SECOND FLOOR RECEPTION
1/2" = 1'-0"

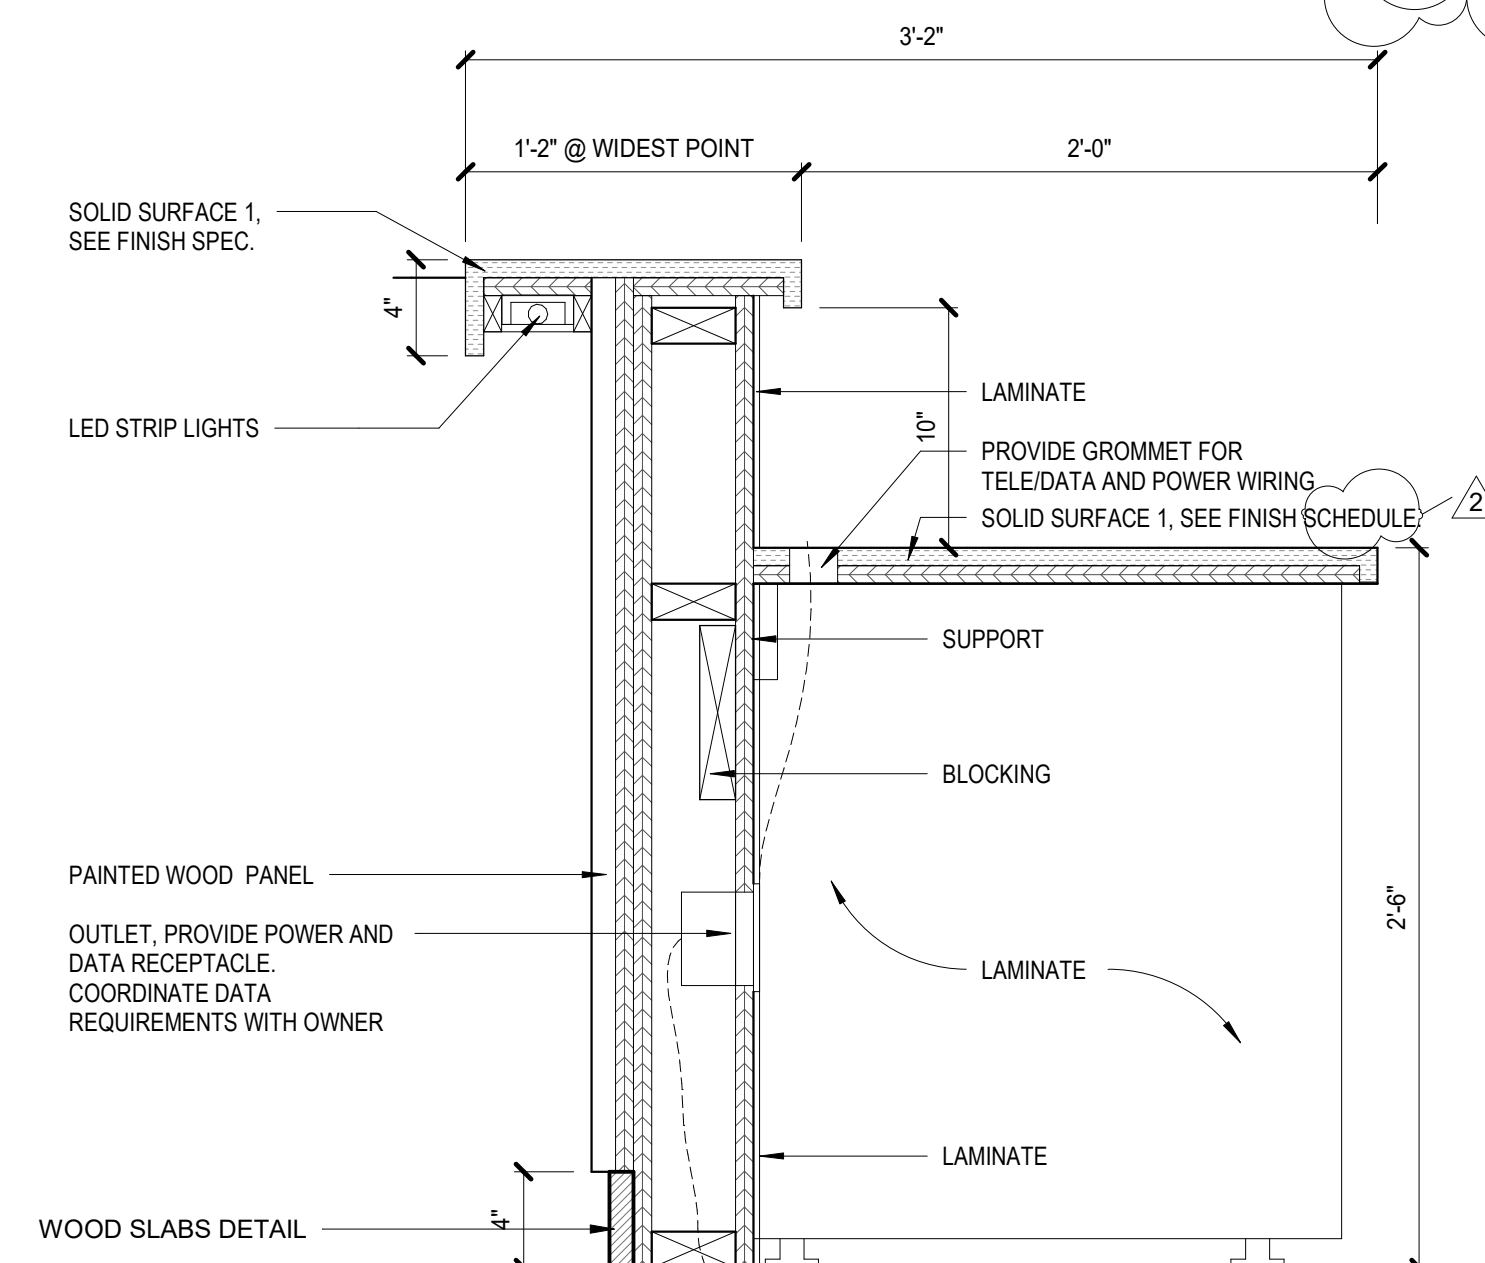


3 1ST & 2ND FLOORS RECEPTION DESK SECTION
1 1/2" = 1'-0"

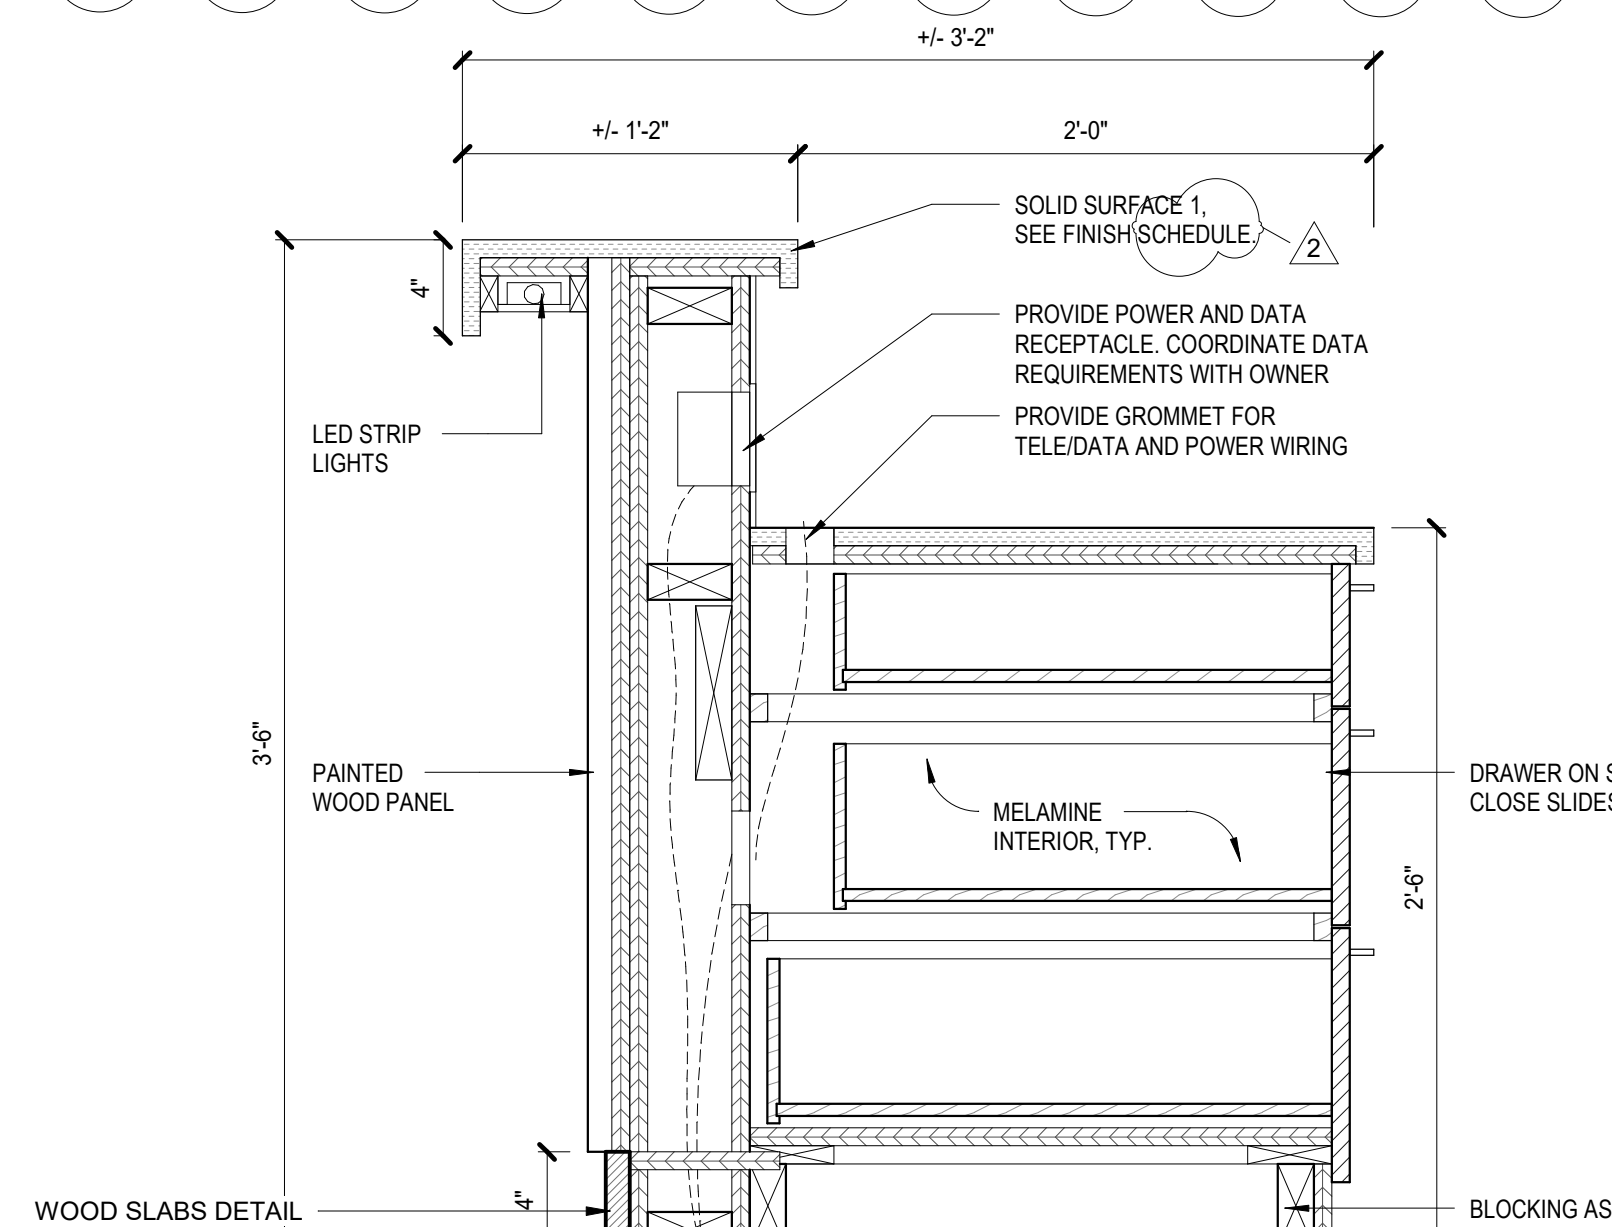


4 1ST & 2ND FLOORS RECEPTION DESK SECTION W/ DRAWERS
1 1/2" = 1'-0"

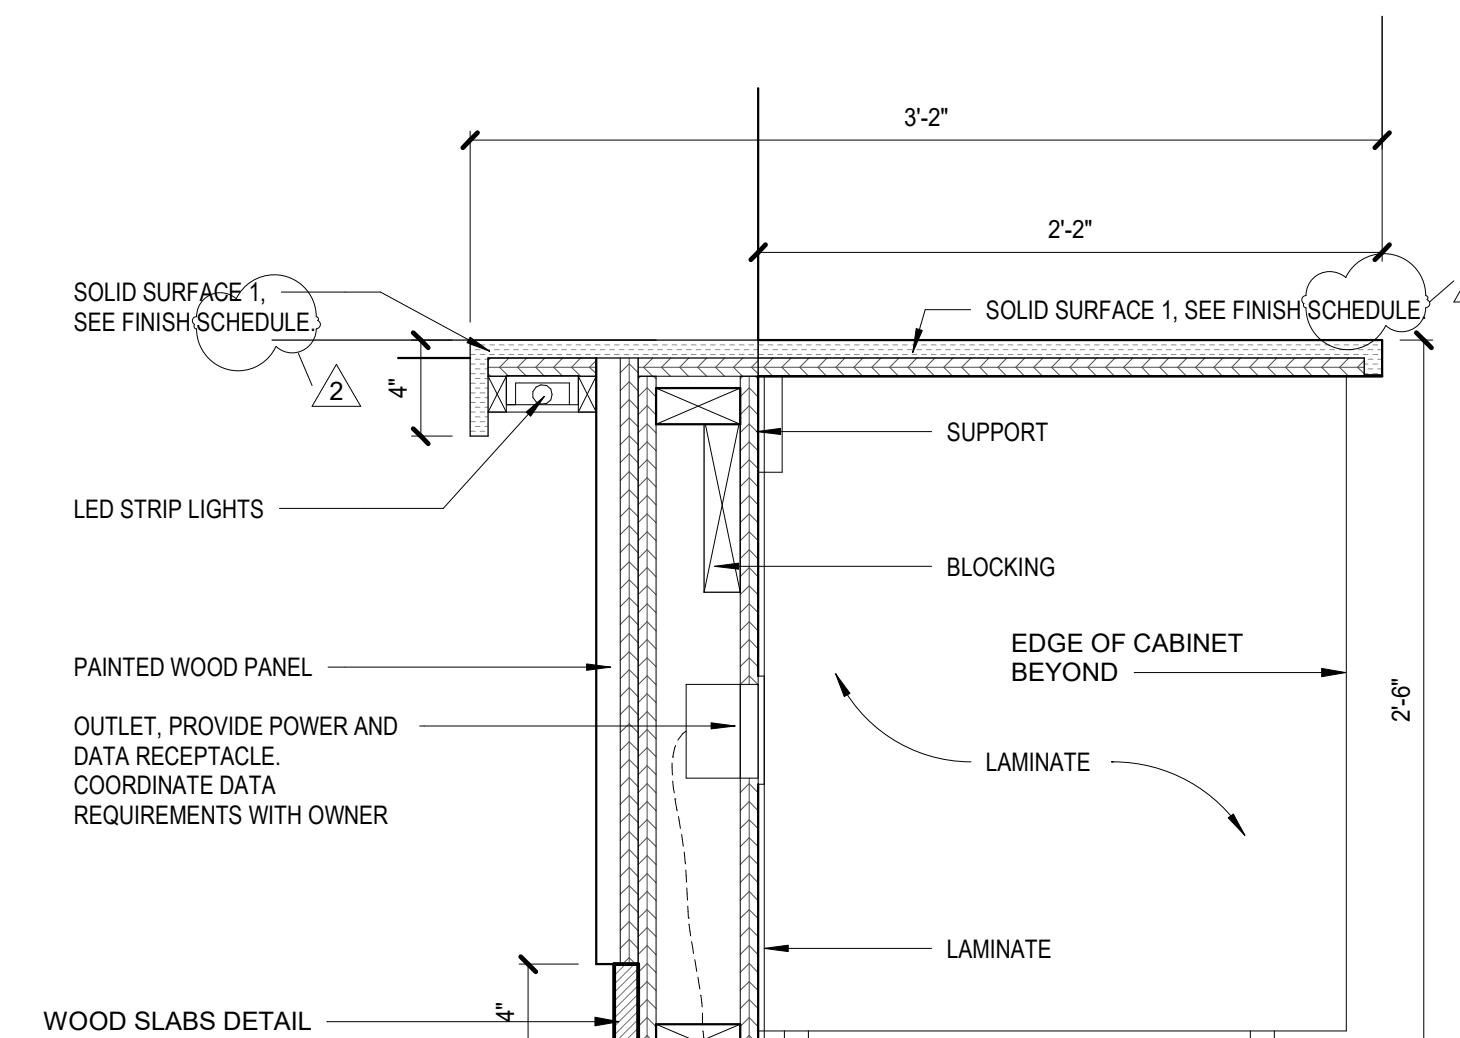


5 1ST FLOOR RECEPTION DESK SECTION
1 1/2" = 1'-0"

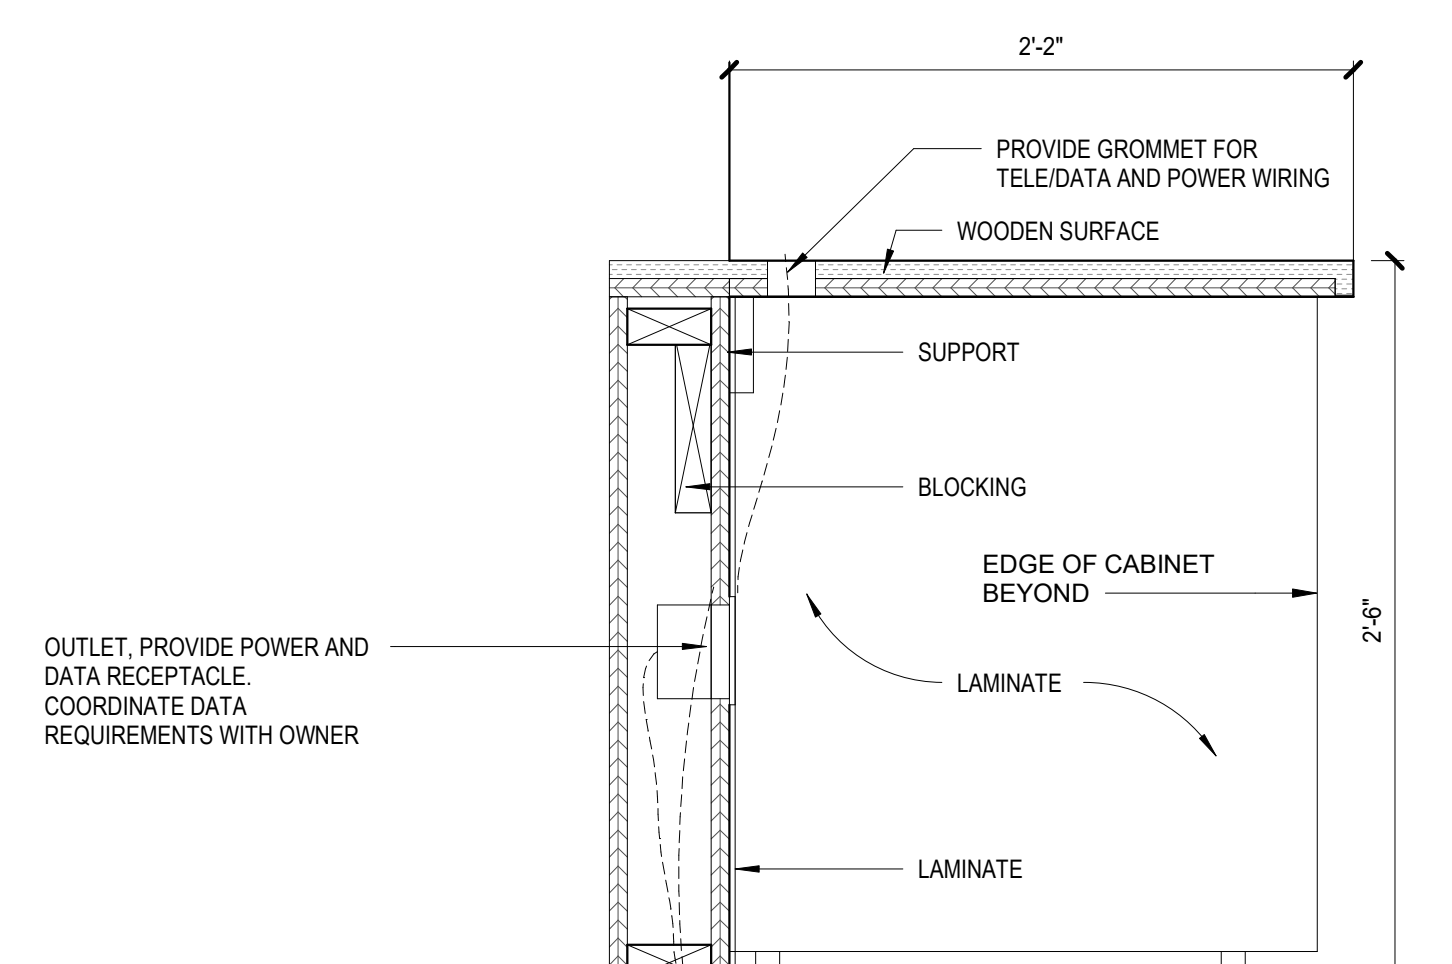


6 2ND FLOOR RECEPTION ADJACENT DESK
1 1/2" = 1'-0"

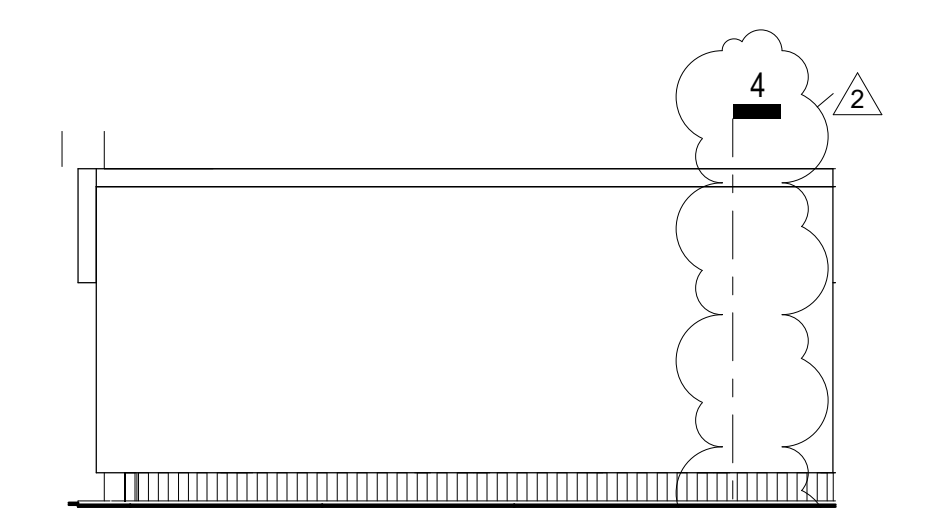


1A RECEPTION 1ST FLOOR - FRONT ELEVATION A
1/2" = 1'-0"

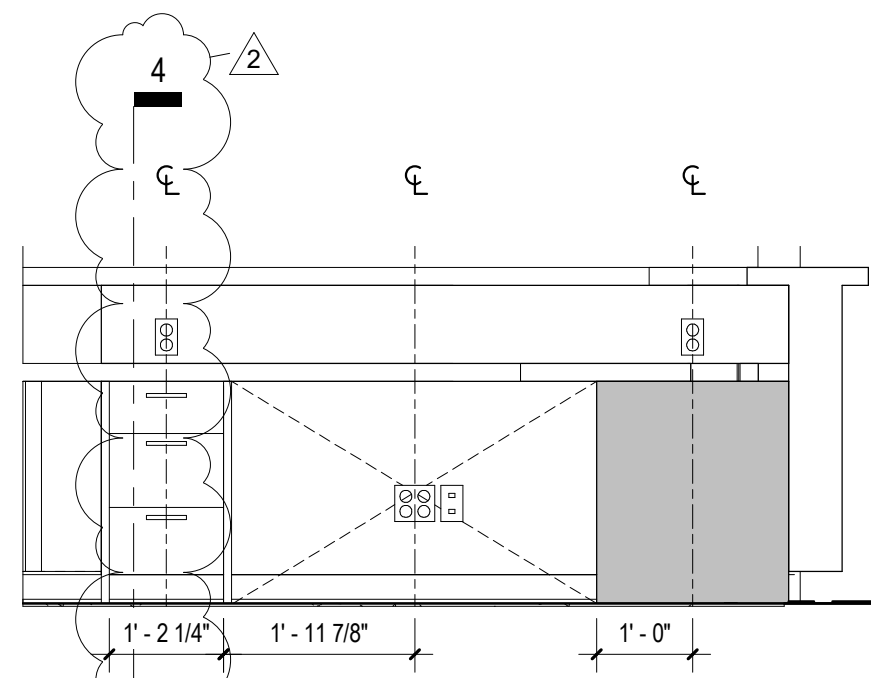


1C RECEPTION 1ST FLOOR - FRONT ELEVATION B
1/2" = 1'-0"

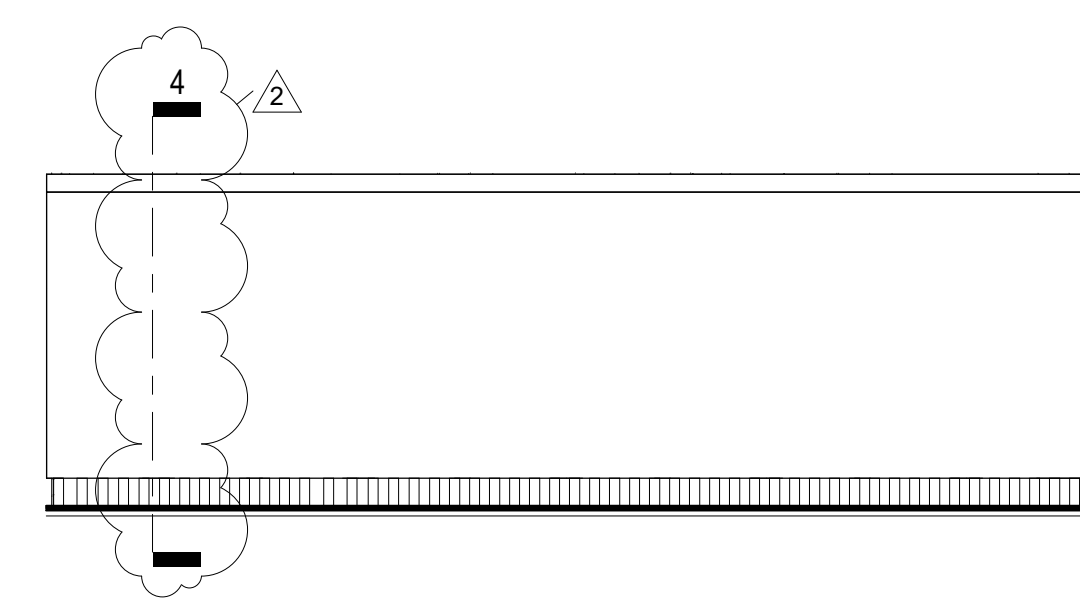


2A RECEPTION 2ND FLOOR - FRONT ELEVATION A
1/2" = 1'-0"

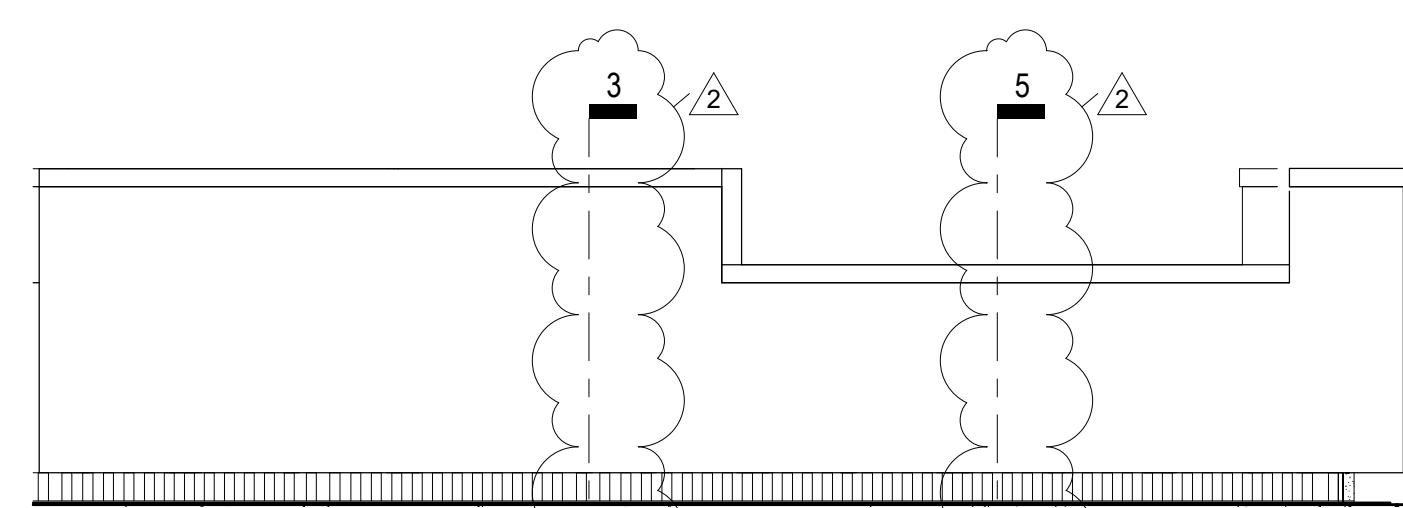


1B RECEPTION 1ST FLOOR - SIDE ELEVATION A
1/2" = 1'-0"

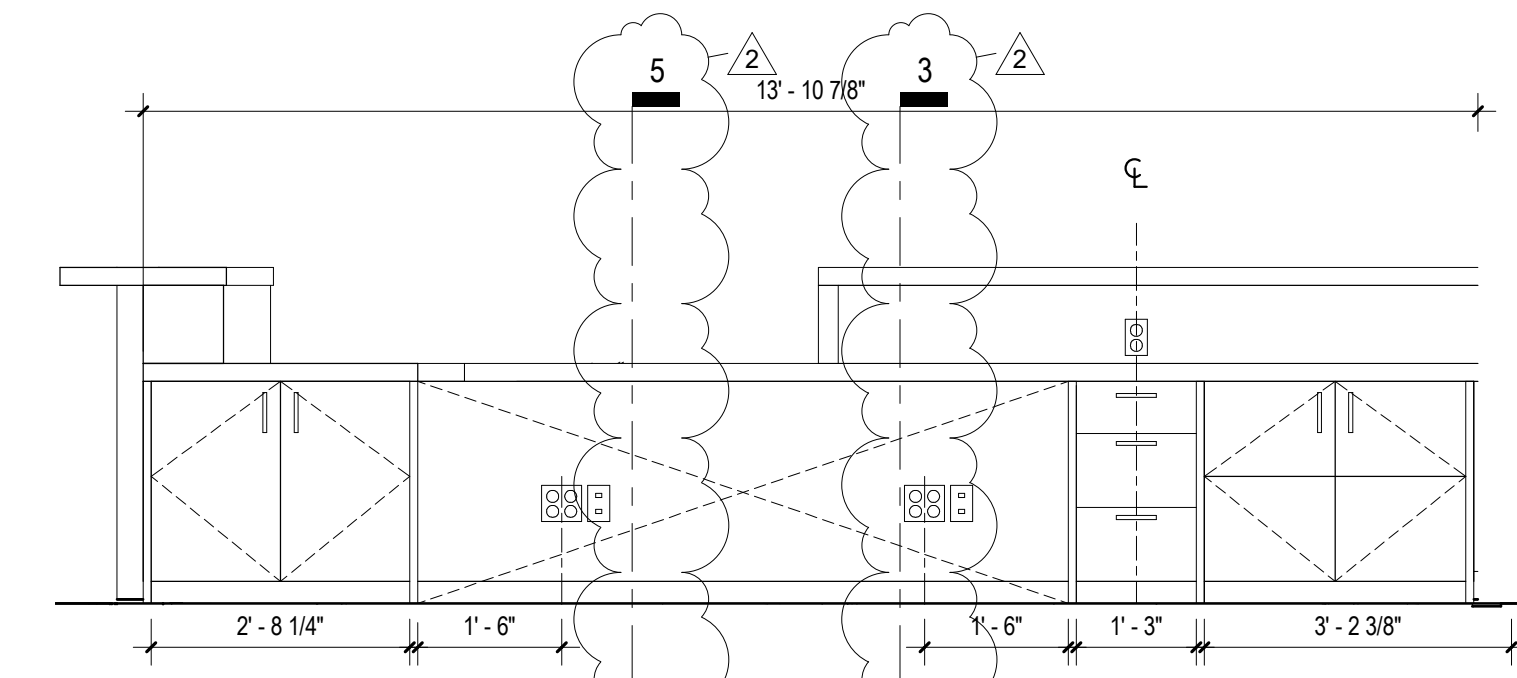


1D RECEPTION 1ST FLOOR - SIDE ELEVATION B
1/2" = 1'-0"

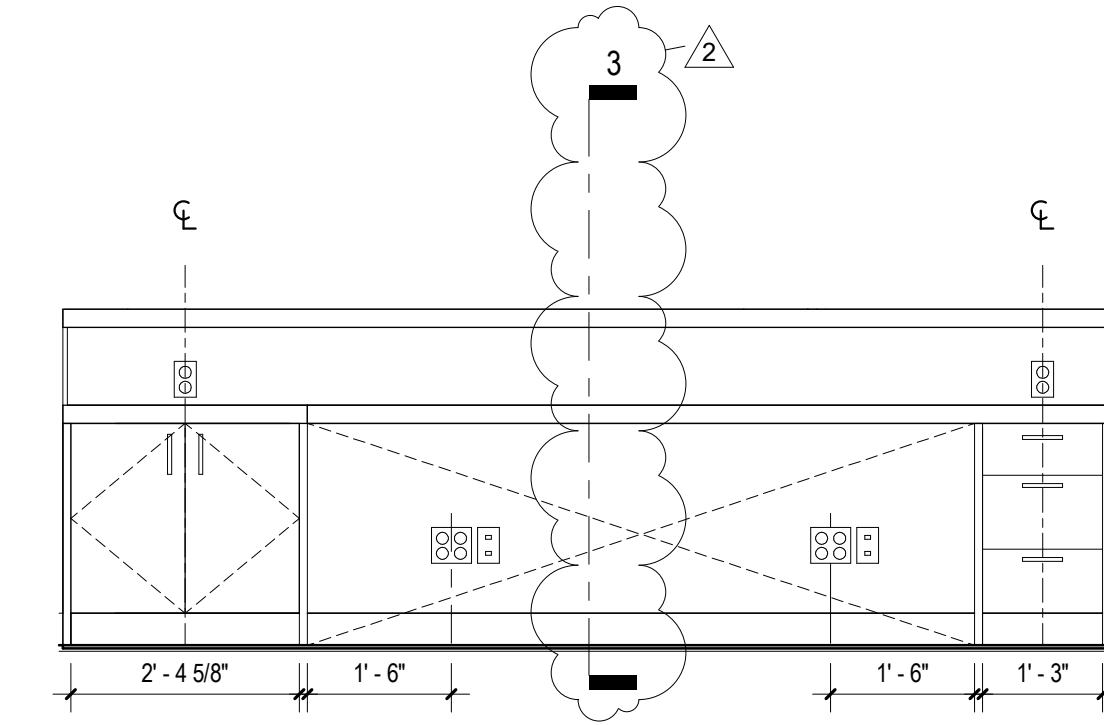


2B RECEPTION 2ND FLOOR - FRONT ELEVATION B
1/2" = 1'-0"

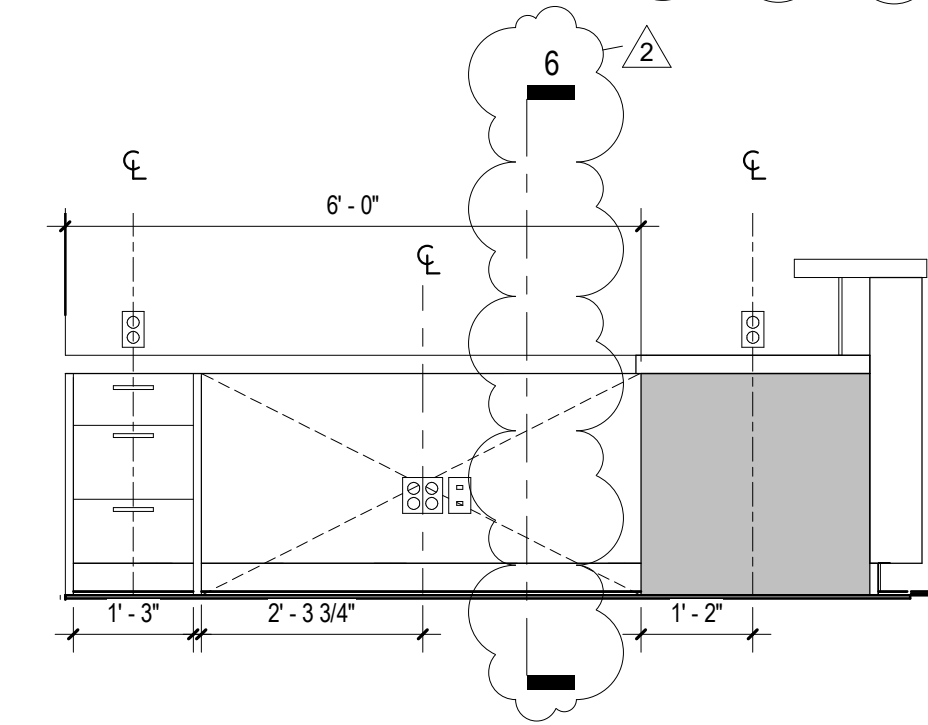


2C RECEPTION 2ND FLOOR - SIDE ELEVATION
1/2" = 1'-0"

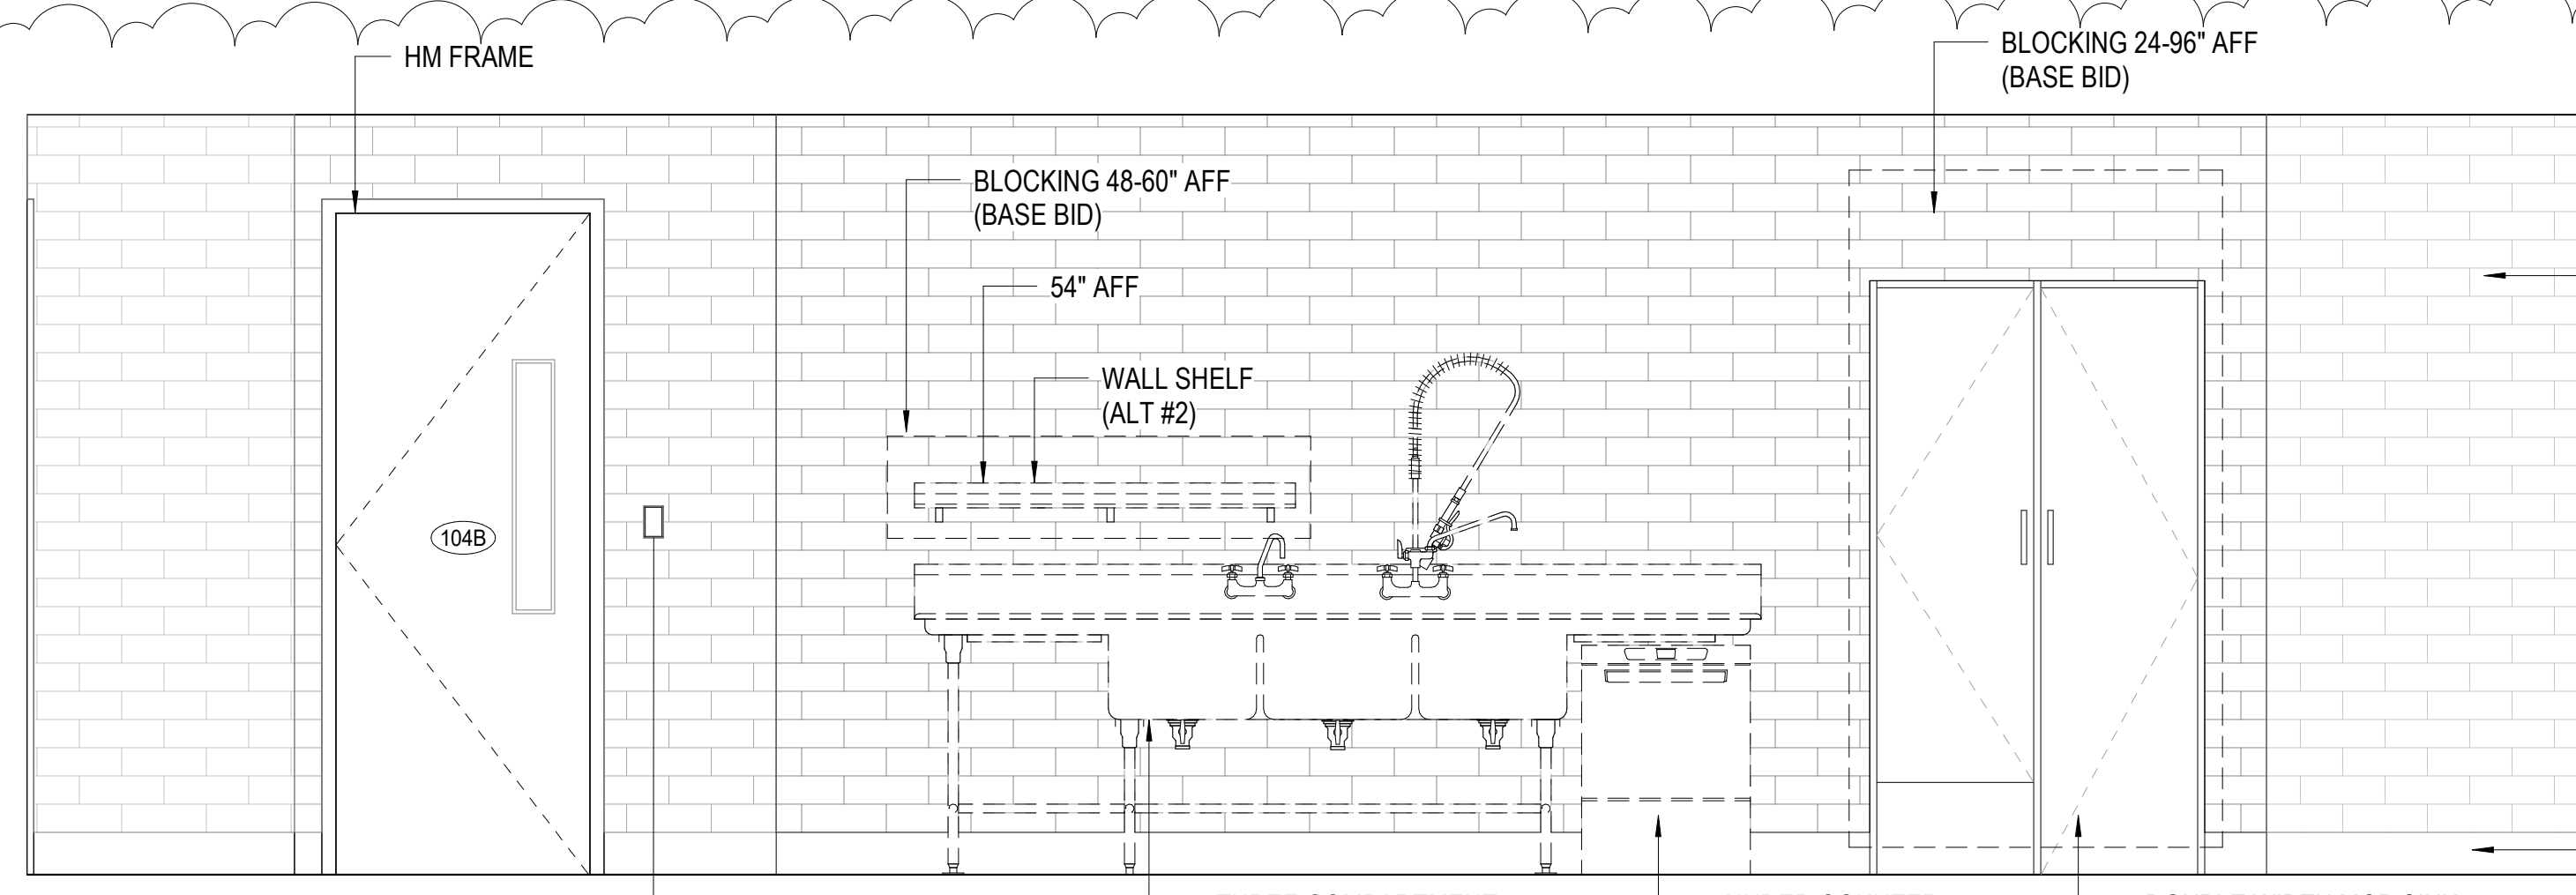


11 KITCHEN NORTH ELEVATION
1/2" = 1'-0"

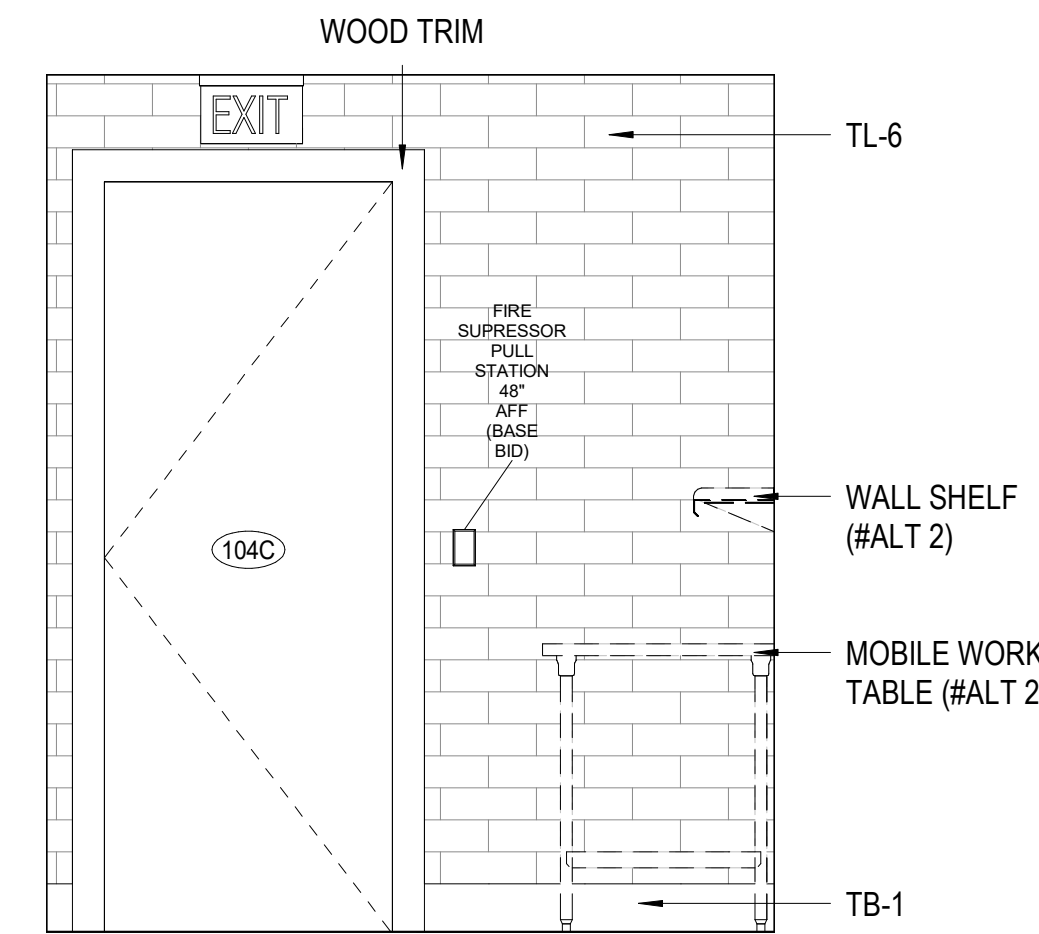


7 KITCHEN EAST ELEVATION - EXTERIOR WALL
1/2" = 1'-0"

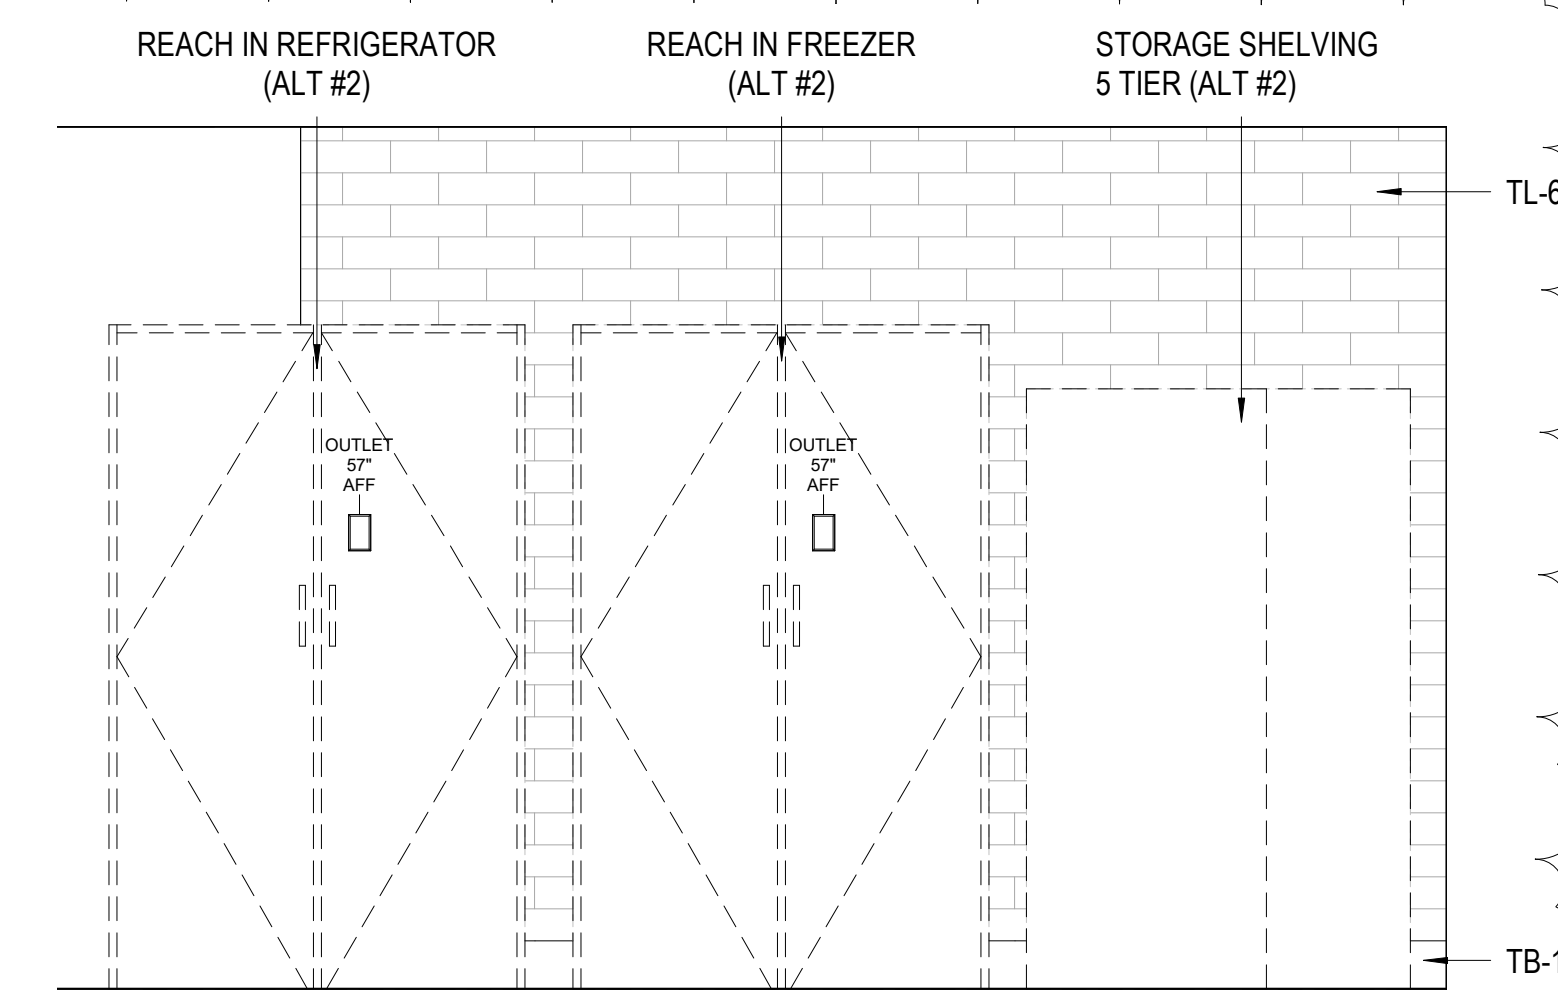

8 KITCHEN EAST ELEVATION
1/2" = 1'-0"

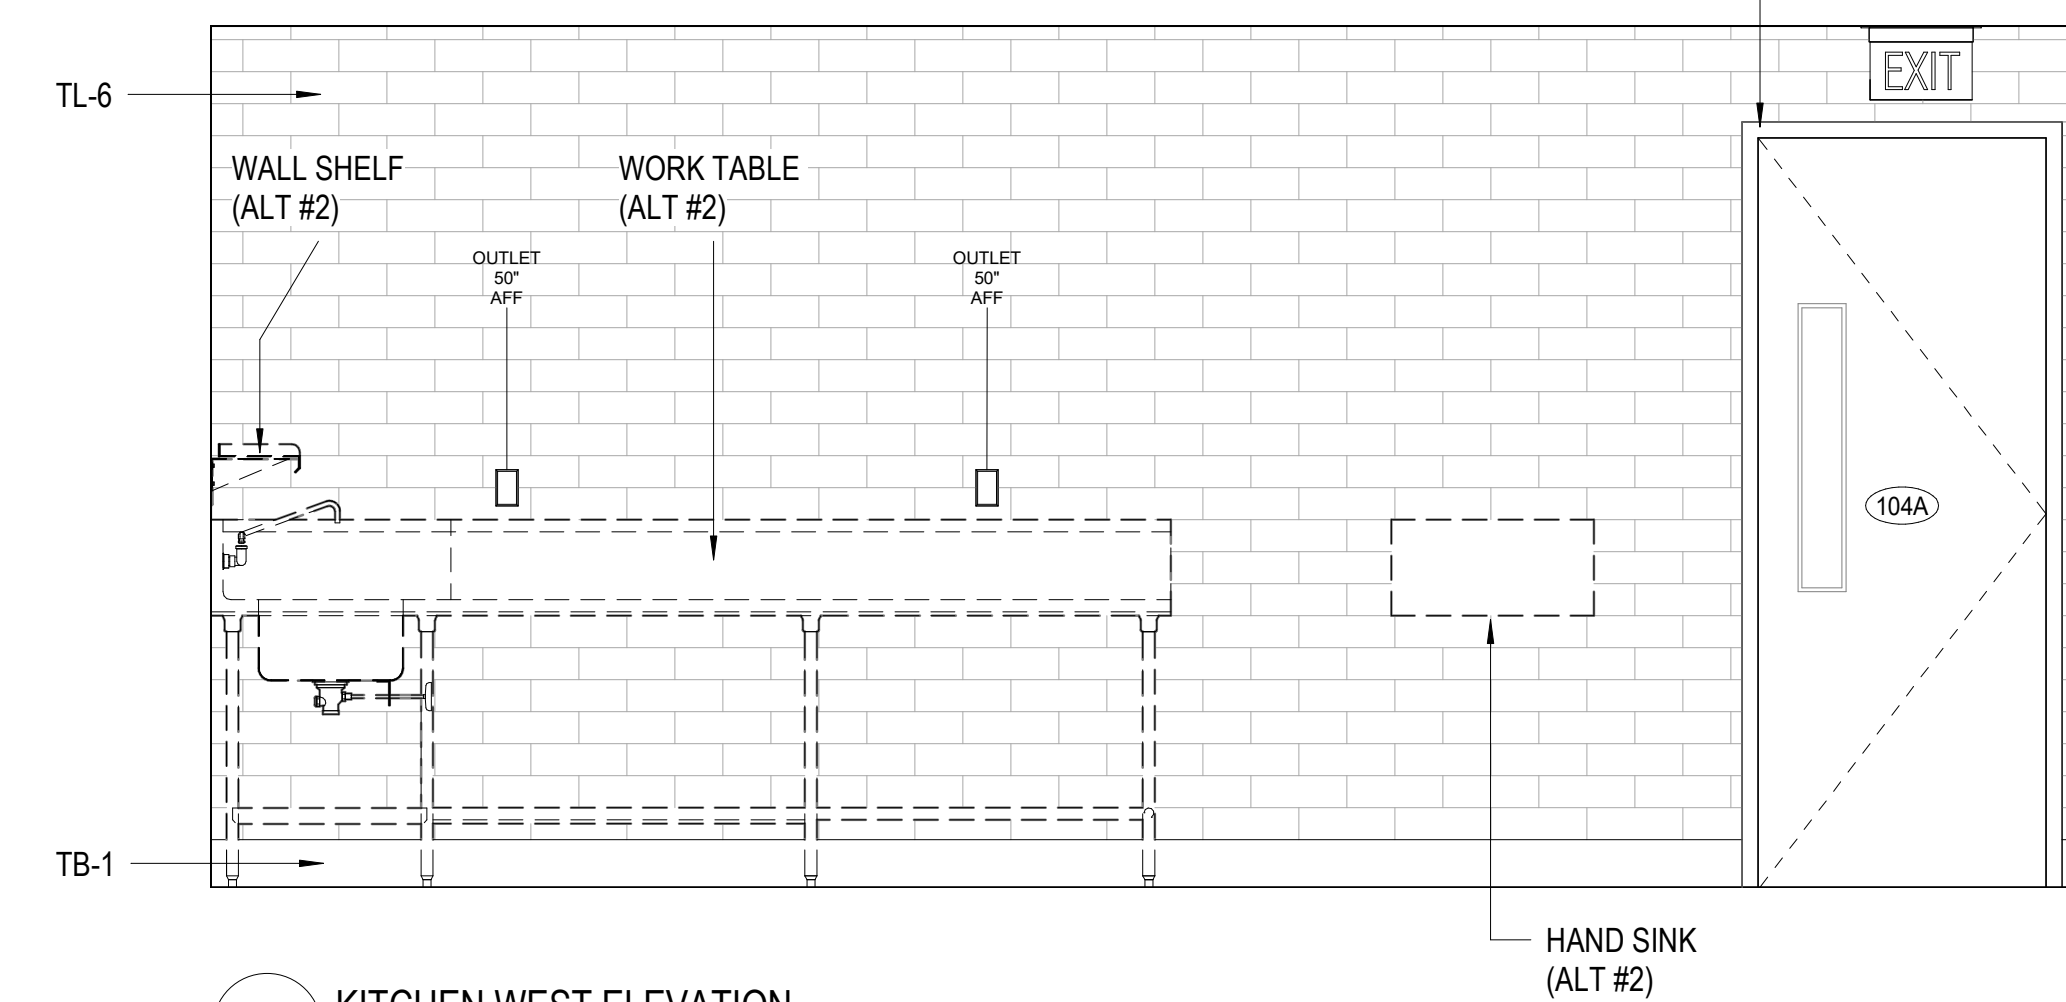

9 KITCHEN WEST ELEVATION
1/2" = 1'-0"

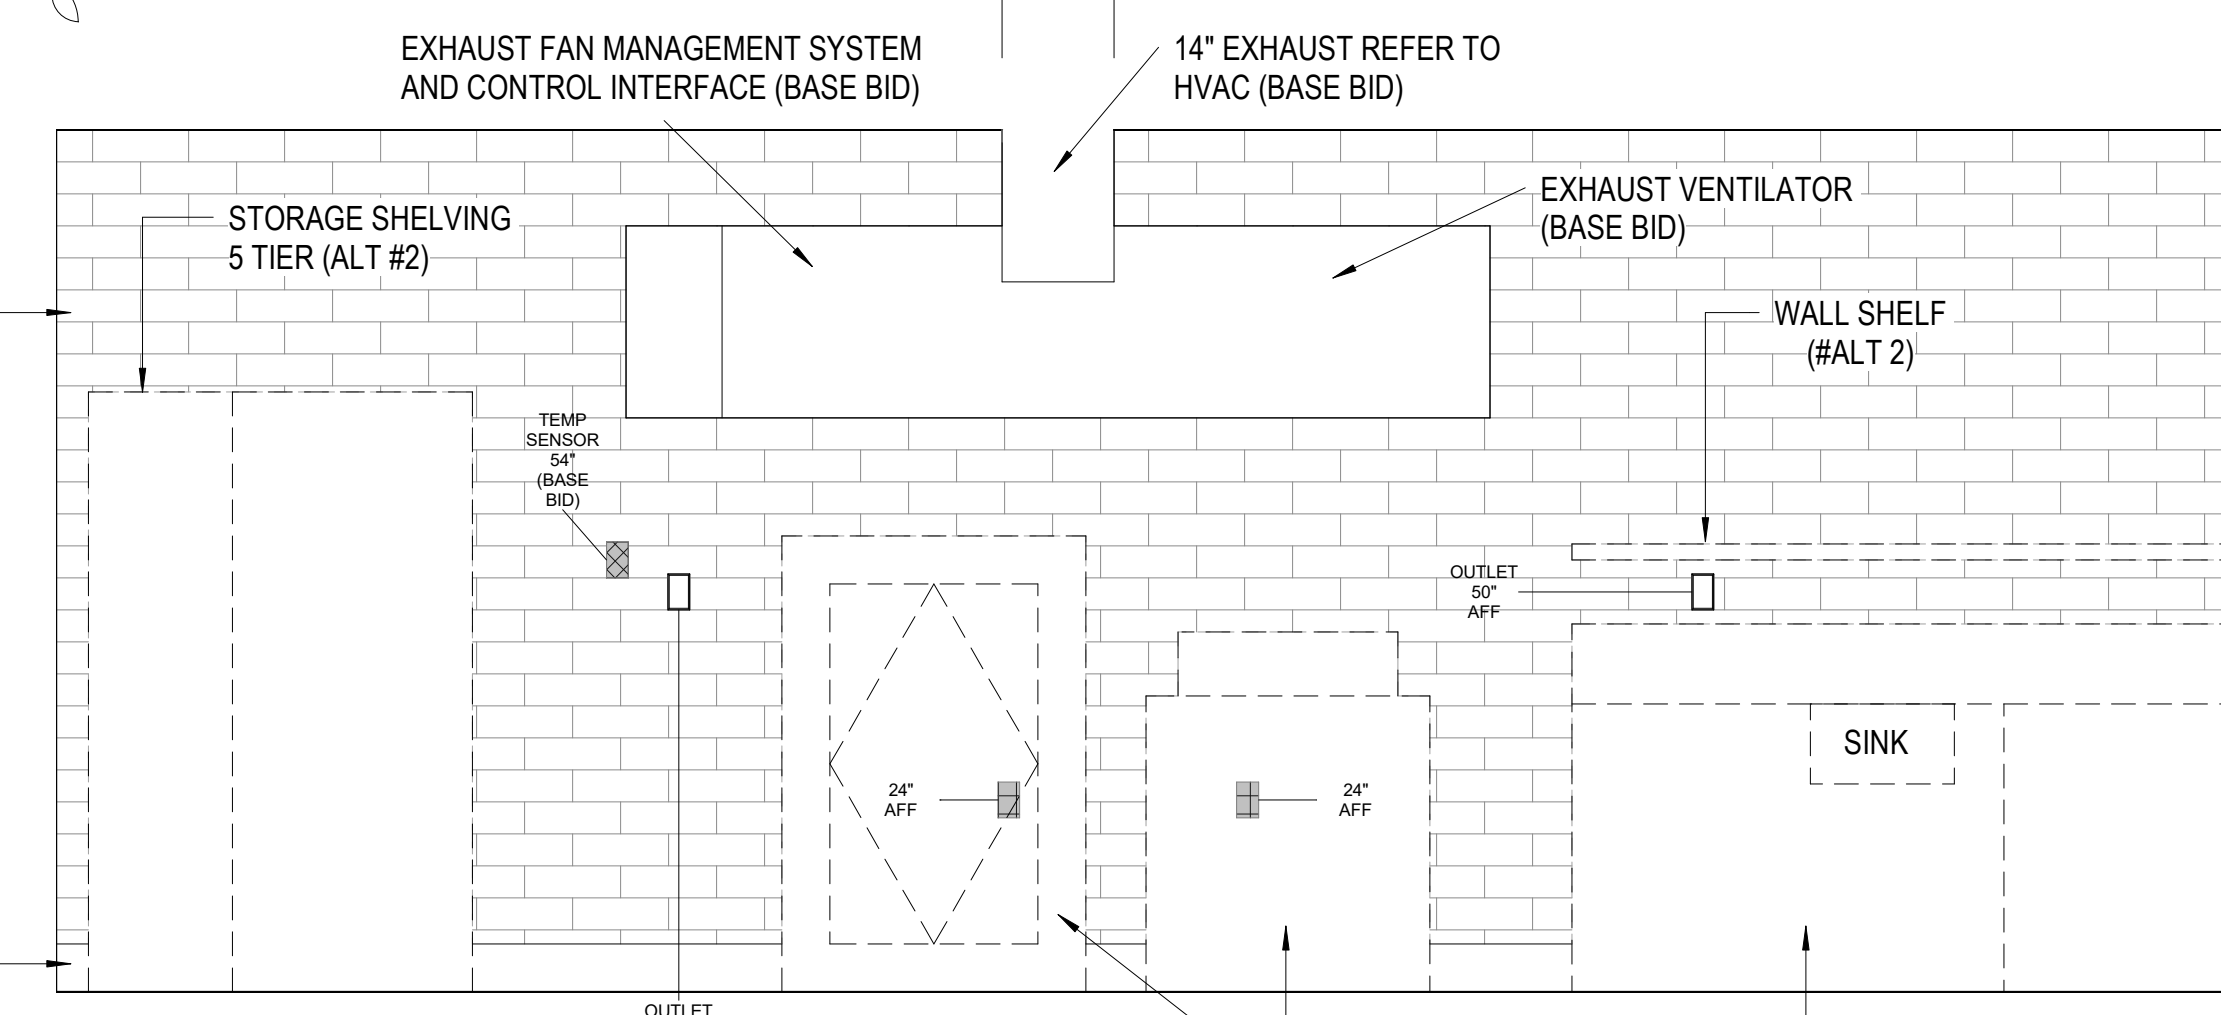

10 KITCHEN SOUTH ELEVATION
1/2" = 1'-0"

NOTES:
1. FURNITURE SHOWN FOR REFERENCE ONLY
2. REFER TO DRAWING FS100 AND KITCHEN EQUIPMENT SPECIFICATION 114000 FOR ADDITIONAL ALTERNATE 2 AND BASE BID INFO.

ARCHITECT
bh+a
Bergmann Hendrie + Archetype, Inc.
9 Channel Center Street, Suite 300
Boston, MA 02210
(617) 350-0450

PROJECT NAME
Pembroke Community Center
128 Center Street
Pembroke, MA, 02359

CLIENT
Town of Pembroke MA
100 Center Street
Pembroke, MA, 02359

PROJECT TEAM
Civil Engineer & Site Surveyor
Meritt Engineers & Land Surveyors
427 Columbia Road
Haverhill, MA, 02339
(817) 826-9200
Landscape Architect
Kyle Zick Landscape Architecture, Inc.
36 Bromfield Street, Suite 202
Boston, MA, 02108
(617) 451-1018
Structural Engineer
Foley Buhl Roberts & Associates, Inc.
2150 Washington Street
Newton, MA, 02462
(617) 527-9600
MEP/FP Engineer
Allied Consulting Engineering Services
235 Littleton Road, Suite 5
Westford, MA, 01886
(978) 443-7888
Audio/Visual
Pro AV Systems
275 Billerica Road, Suite 3
Chelmsford, MA 01824
(978) 692-5111
Elevator Consultant
B Squared Engineering
169 Mill Brook Road
Stamford, CT, 06902
(203) 989-9029
Food Service Consultant
Crabtree McGrath Associates
161 West Main Street
Georgetown, MA 01833
(978) 332-8500
Technology and Security
Building Technology Consulting
992 Bedford Street
Bridgewater, MA 02424
(508) 819-1550


REVISIONS
2 Addendum #2 08/03/2022
DATE

DRAWING TITLE
Reception Desks and Kitchen Elevations


DRAWING INFORMATION
07/22/22
DATE OF ISSUE
Construction Documents
DESCRIPTION
As indicated GK DRAWN BY
3403.00 Penelope PROJECT # FILE NAME
DRAWING NUMBER
A524

Copyright BH+A, Inc. V.2.1


	101	LOBBY	101	VESTIBULE	100	6'-0"	7'-10"	0'-1 3/8"	D8	FIBERGLASS	FIBERGLASS			
	102A	GYM STORAGE	105A	GYM LOBBY	106	3'-0"	7'-10"	0'-2"	D1	FIBERGLASS	HM			
	102B	MULTIPURPOSE ROOM	102	LOBBY	101	6'-0"	7'-10"	0'-2"	D8	WOOD	HM			
	102C	MULTIPURPOSE ROOM	102	MULTIPURPOSE ROOM	102	4'-6"	10'-0"	0'-2"	D8	WOOD	HM			BI-FOLDING PANEL PARTITION
	102E	MULTIPURPOSE ROOM	102	LOBBY	101	3'-0"	7'-10"	0'-1 3/4"	D2	FIBERGLASS	FIBERGLASS			
	102F	MULTIPURPOSE ROOM	102	LOBBY	101	3'-0"	7'-10"	0'-1 3/4"	D2	FIBERGLASS	FIBERGLASS			
	104A	GYM LOBBY	103	KITCHEN	104	3'-0"	7'-10"	0'-1 3/4"	D4	WOOD	HM			
	104B	KITCHEN	104	MULTIPURPOSE ROOM	102	3'-0"	7'-10"	0'-1 3/4"	D4	WOOD	HM			
	104C	KITCHEN	104	MULTIPURPOSE ROOM	102	3'-0"	7'-10"	0'-1 3/4"	D1	FIBERGLASS	FIBERGLASS	CARD READER	/2	
	104E	ELEC.	105		103	3'-0"	7'-10"	0'-1 3/4"	D1	HM	HM	CARD READER	/2	OPOSING SWING DOUBLE LEAF DOOR
	106A	GYM	106	GYM LOBBY	103	6'-0"	7'-4"		D8	WOOD	HM	DUAL SWING		
	106B	GYM	106	GYM STORAGE	106A	3'-0"	7'-10"		D11	OVERHEAD COILING BARN DOOR	HM			
	106C	GYM	106	GYM STORAGE	106A	15'-5.5/16"	12'-0"	0'-1 1/2"	D11	OVERHEAD COILING BARN DOOR	NA			
	106D	GYM	106		106	15'-0"	12'-0"				NA			
	106E	GYM	106		106	6'-2"	7'-10"	0'-1 3/4"	D7	HM	HM	CARD READER	/2	
	106F	GYM	106		106	6'-2"	7'-10"	0'-1 3/4"	D7	HM	HM			
	108	CORR.	107	CUST.	108	3'-0"	7'-10"	0'-1 3/4"	D1	WOOD	HM			
	109A	WOMENS	107	WOMENS	109	3'-0"	7'-10"	0'-1 3/4"	D1	WOOD	HM			
	109B	WOMENS	107	WOMENS	109	3'-0"	7'-10"	0'-2"	D1	WOOD	HM			
	110A	CORR.	107	MEN	110	3'-0"	7'-10"	0'-1 3/4"	D1	WOOD	HM			
	110B	MEN	110	MEN SHOWER	110A	3'-0"	7'-10"	0'-2"	D1	WOOD	HM			
	111	STO.	111	LOBBY	101	3'-0"	7'-10"	0'-2"	D1	WOOD	HM			
	113	CORR.	112	COMPANION	113	3'-0"	7'-10"	0'-2"	D1	WOOD	HM			
	114	CORR.	112	NURSE-EMS	114	3'-0"	7'-10"	0'-2"	D1	WOOD	HM			
	115	CORR.	112	STAFF	115	3'-0"	7'-10"	0'-1 3/4"	D1	WOOD	HM			
	116	STOR.	116	LOBBY	101	3'-0"	7'-10"	0'-1 3/4"	D1	WOOD	HM			
	119	CORR.	117	CORR.	119	3'-0"	7'-10"	0'-1 3/4"	D2	WOOD	HM	CARD READER	/2	
	120	CORR.	119	ADMIN.	120	3'-0"	7'-10"	0'-1 3/4"	D2	WOOD	HM			
	121	CORR.	119	SC OUTREACH	121	3'-0"	7'-10"	0'-1 3/4"	D2	WOOD	HM			
	122	CORR.	119	SC TRANSPORT COORD	122	3'-0"	7'-10"	0'-1 3/4"	D2	WOOD	HM			
	123	CORR.	119	SC EXEC. DIRECTOR	123	3'-0"	7'-10"	0'-1 3/4"	D2	WOOD	HM			
	124	CORR.	119	DISABILITY / SHINE	124	3'-0"	7'-10"	0'-1 3/4"	D2	WOOD	HM			
	125	CORR.	119	COPY	125	3'-0"	7'-10"	0'-1 3/4"	D1	WOOD	HM			
	126A	CORR.	117	SC LOUNGE	126	3'-0"	7'-10"	0'-1 3/4"	D2	WOOD	HM			
	126B	SC LOUNGE	126	SC LOUNGE	126	3'-0"	7'-10"	0'-1 3/4"	D2	FIBERGLASS	FIBERGLASS	CARD READER	/2	
	126C	SC MULTIPURPOSE ROOM	127	SC LOUNGE	126	3'-0"	7'-10"	0'-1 3/4"	D2	WOOD	HM			
	127A	SC MULTIPURPOSE ROOM	127	CORR.	112	3'-0"	7'-10"	0'-1 3/4"	D2	WOOD	HM			
	127B	SC MULTIPURPOSE ROOM	127		126	3'-0"	8'-0"	0'-1 3/4"	D8	FIBERGLASS	FIBERGLASS			
	128	WATER SERVICE	128		128	3'-0"	7'-10"	0'-1 3/4"	D1	HM	HM			
	201A	PROGRAM ROOM 3	201	CORRIDOR	200	3'-0"	7'-10"	0'-1 3/4"	D2	WOOD	HM			
	201B	STORAGE	201A	PROGRAM ROOM 3	201	6'-0"	7'-10"	0'-1 3/4"	D7	WOOD	HM			
	201C	PROGRAM ROOM 2	202	PROGRAM ROOM 3	201	4'-0"	10'-0"	0'-2"	D2	WOOD	HM			BI-FOLDING PANEL PARTITION
	202A	PROGRAM ROOM 2	202	CORRIDOR	200	3'-0"	7'-10"	0'-1 3/4"	D7	WOOD	HM			
	202B	STORAGE	202A	PROGRAM ROOM 2	202	6'-0"	7'-10"	0'-1 3/4"	D7	WOOD	HM			
	203A	PROGRAM ROOM 1	203	CORRIDOR	200	3'-0"	7'-10"	0'-1 3/4"	D2	WOOD	HM			
	203B	STORAGE	203A	PROGRAM ROOM 1	203	6'-0"	7'-10"	0'-1 3/4"	D7	WOOD	HM			
	205	CORR.	204	STO.	205	3'-0"	7'-10"	0'-1 3/4"	D1	WOOD	HM	CARD READER	/2	
	206	MECH.	204	CORR.	204	3'-0"	7'-10"	0'-1 3/4"	D1	WOOD	HM			
	206A	BDA	206A	MECH.	206	3'-0"	7'-10"	0'-1 3/4"	D1	HM	HM			2HR RATED DOOR & FRAME
	206HHH													
	206JJJ													
	207	MDF	207	STO.	206	3'-0"	7'-10"	0'-1 3/4"	D1	HM	HM	CARD READER	/2	OPOSING SWING DOUBLE LEAF DOOR
	208A	WALKING TRACK	208	CORR.	204	6'-0"	7'-10"		D8	WOOD	HM	DUAL SWING		
	208B	WALKING TRACK	208		204	3'-0"	7'-10"	0'-1 3/4"	D1	HM	HM			
	209	CORR.	204	CUST	209	3'-0"	7'-10"	0'-2"	D1	WOOD	HM			
	210	CORR.	204	WOMEN	210	3'-0"	7'-10"	0'-1 3/4"	D1	WOOD	HM			
	211	MEN	211	CORR.	204	3'-0"	7'-10"	0'-1 3/4"	D1	WOOD	HM			

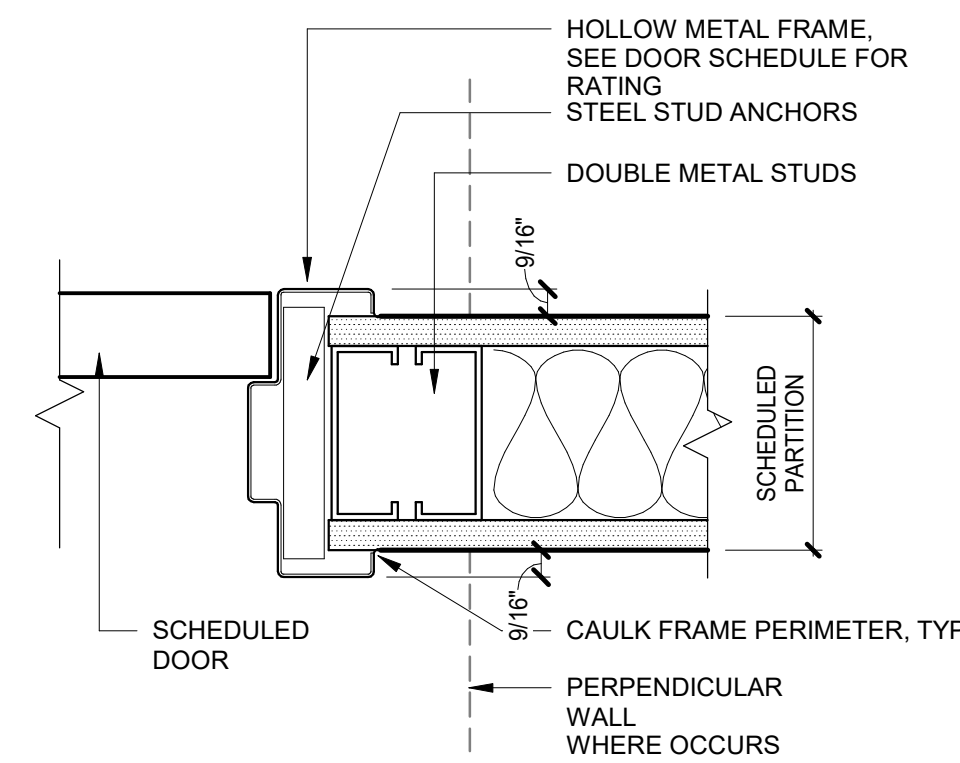


3 HOLLOW METAL JAMB
3" = 1'-0"

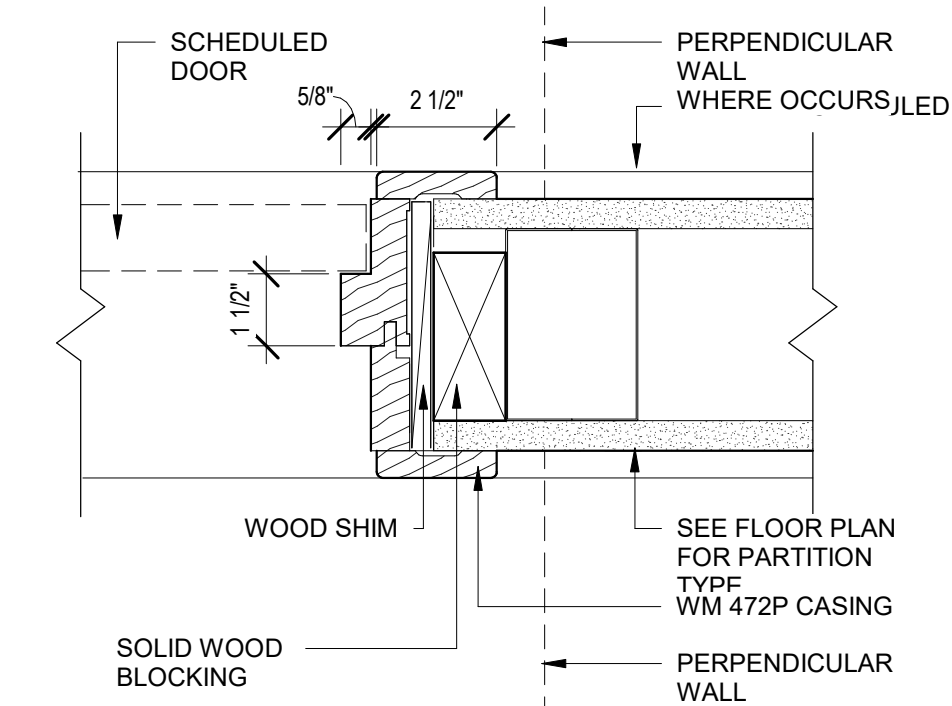


5 INTERIOR WOOD JAMB IN METAL STUD WALL
3" = 1'-0"

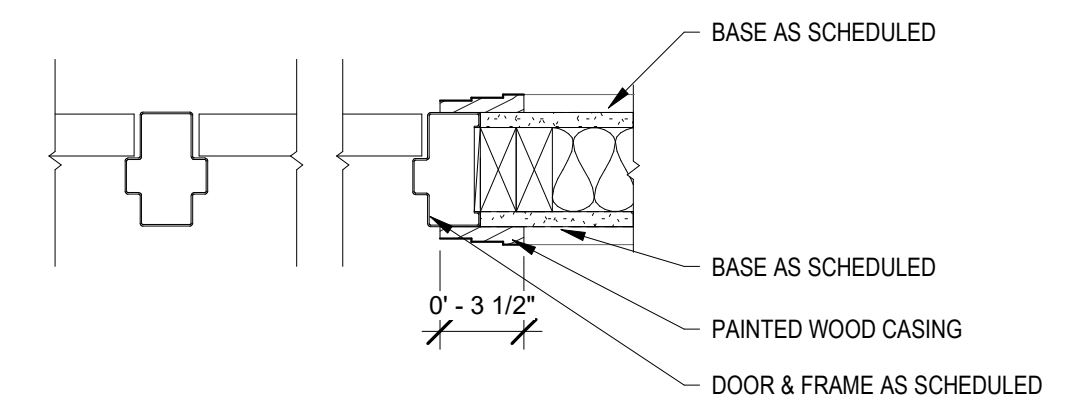


7 INT DOOR JAMB - HM FRAME
1 1/2" = 1'-0"

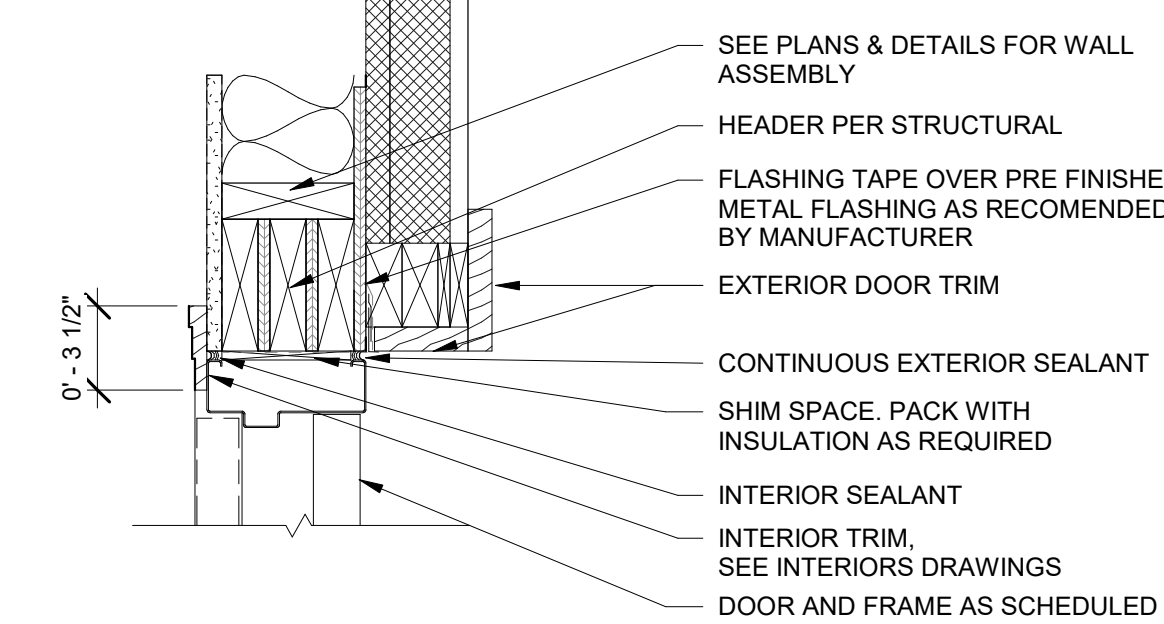


8 EXT - HM DOOR HEAD
1 1/2" = 1'-0"

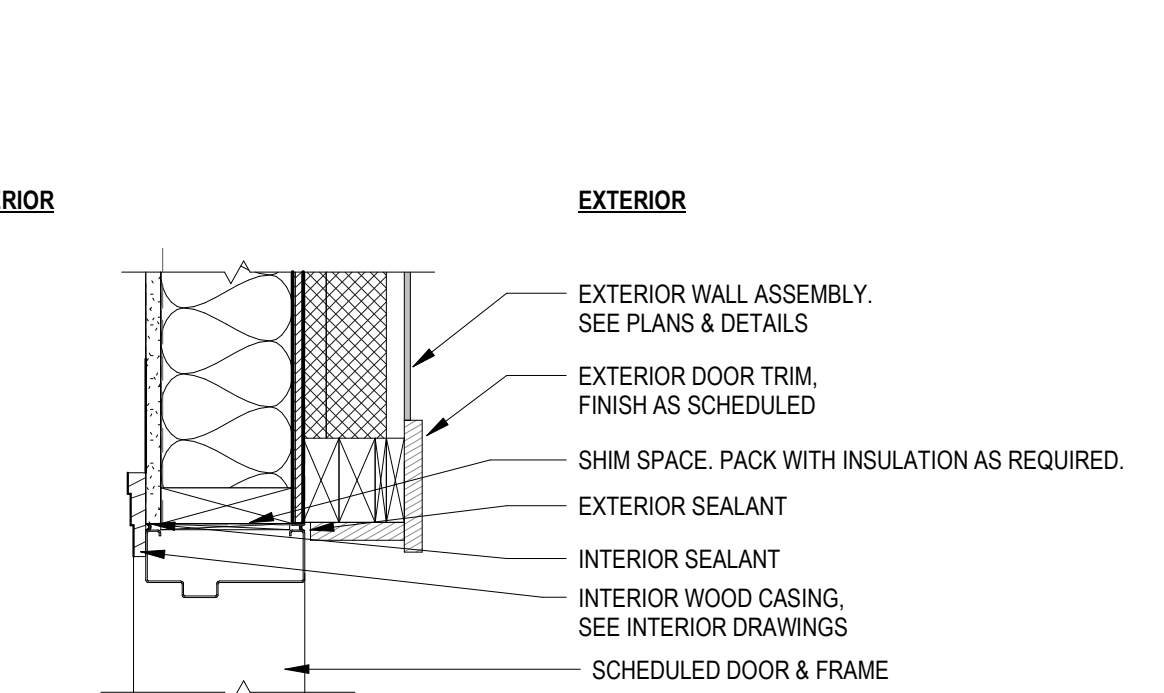


10 EXT - HM DOOR JAMB AT SIDING
1 1/2" = 1'-0"

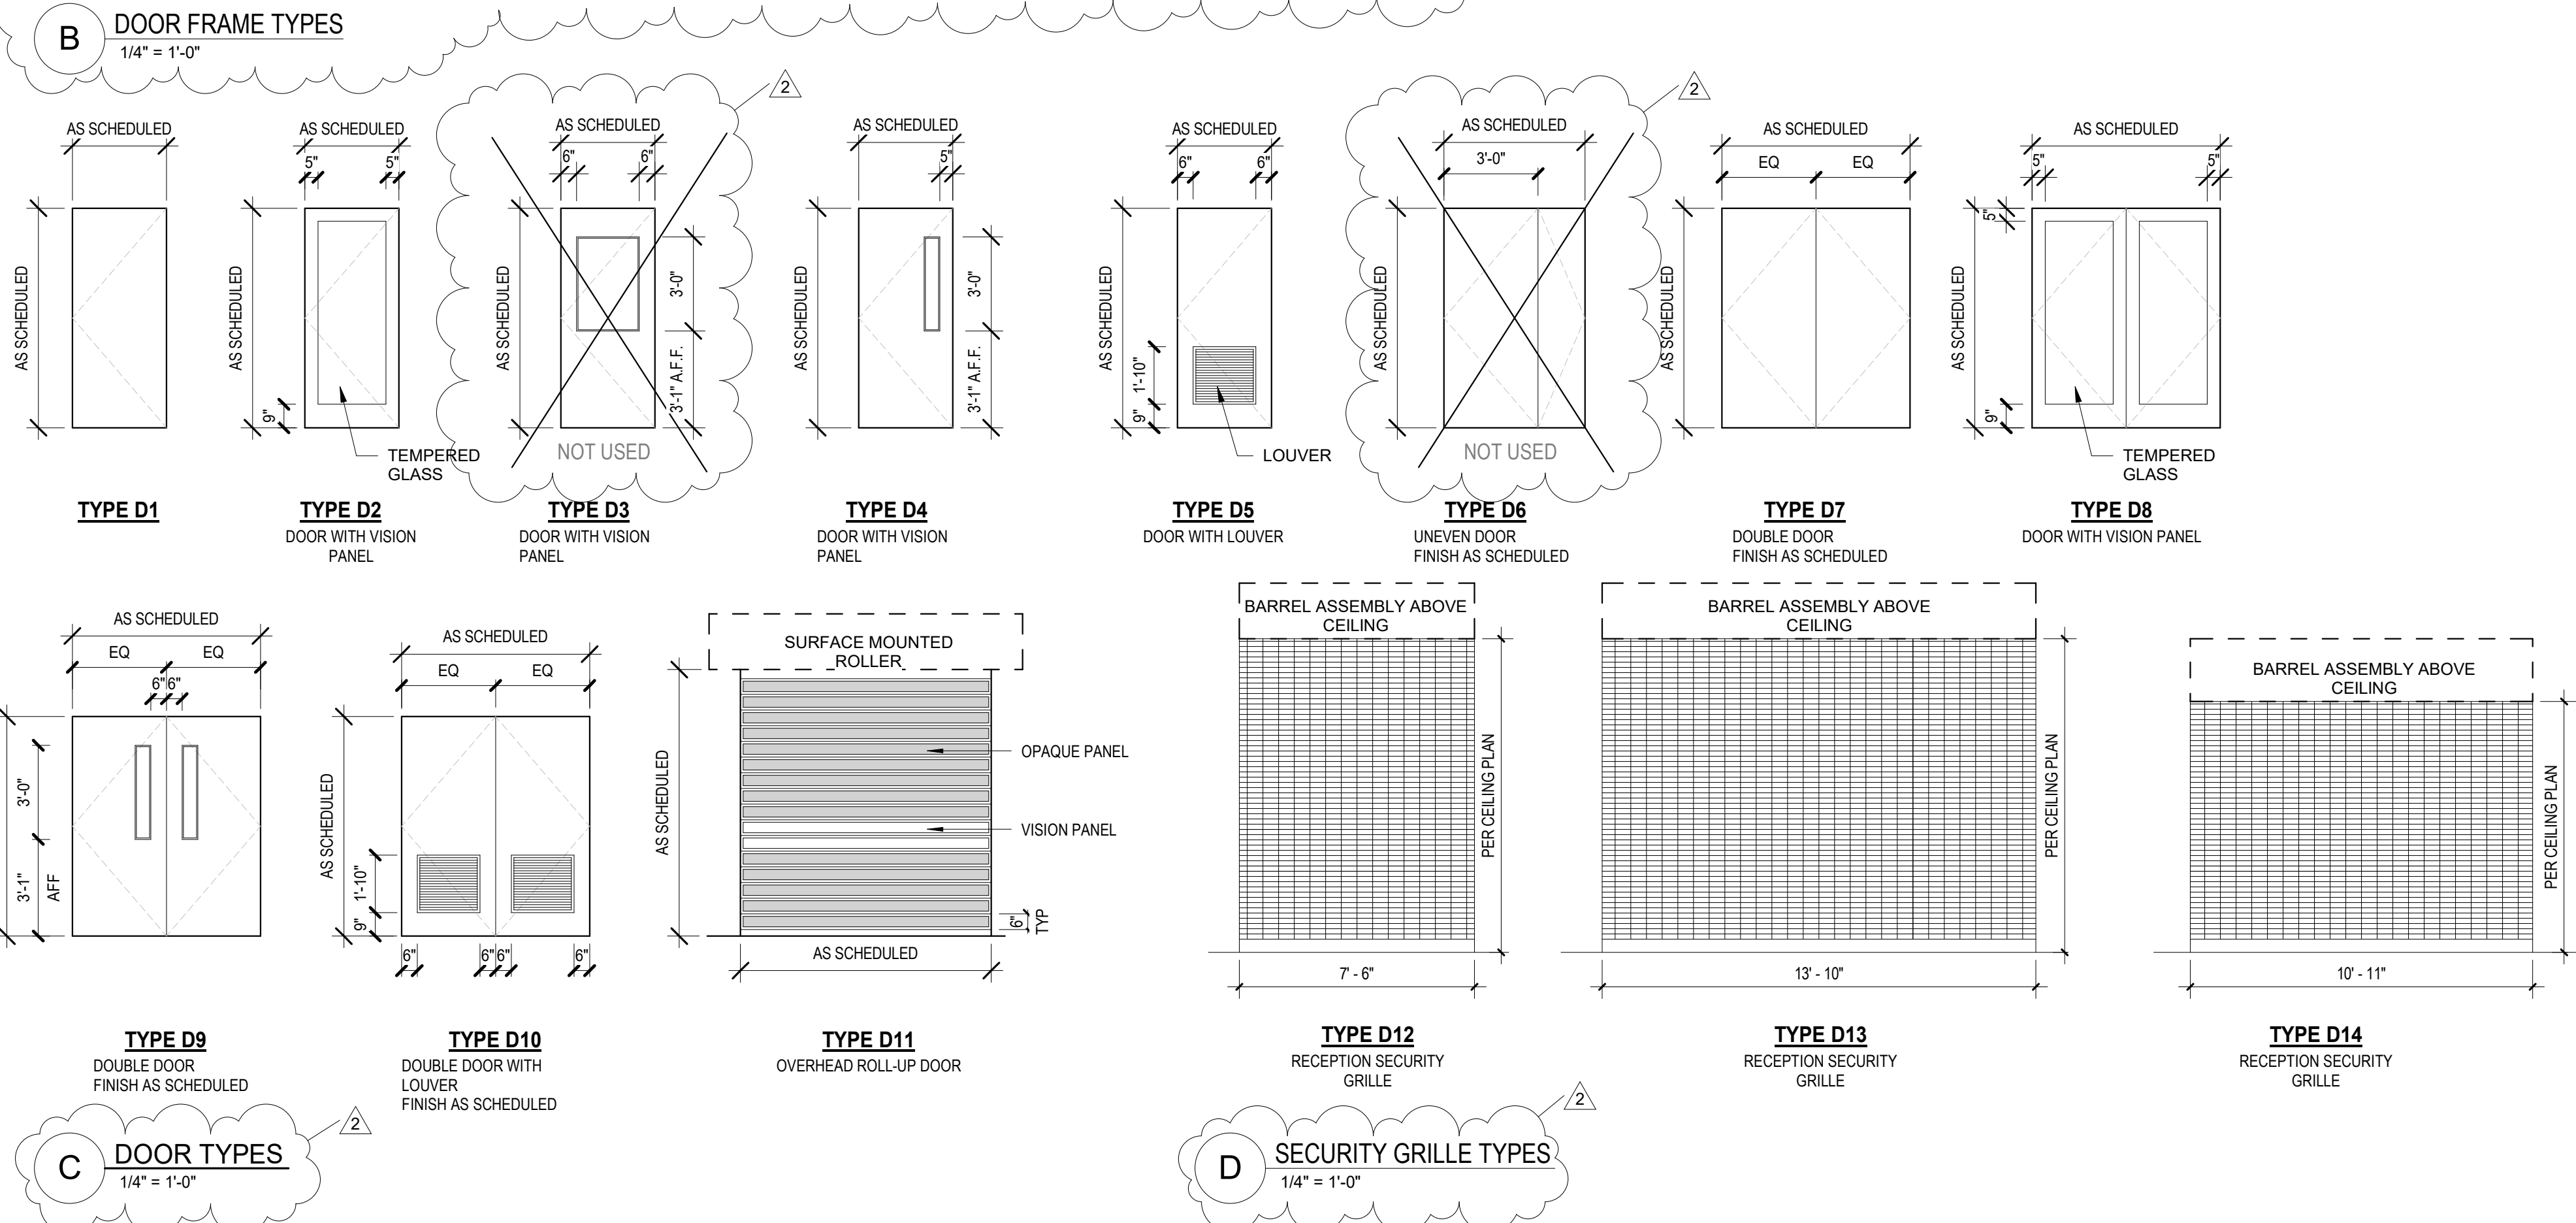

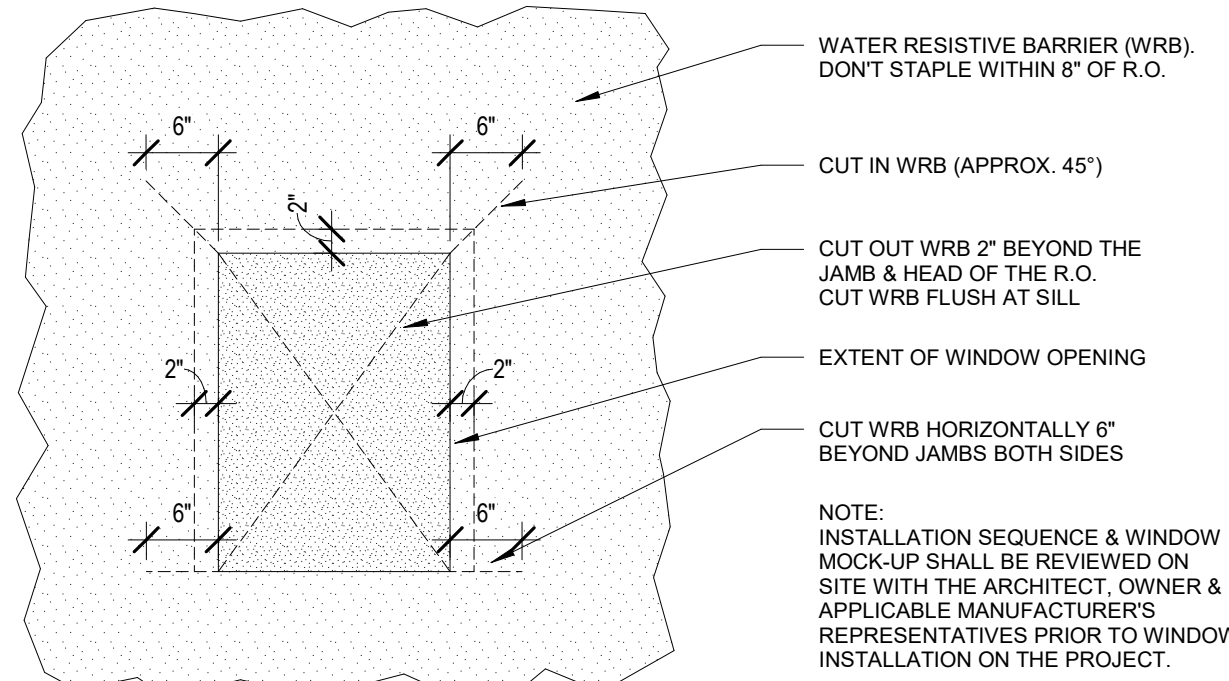


STEP 1

ALL SURFACES ARE TO BE CLEAN AND DRY
INSTALL WATER RESISTIVE BARRIER (WRB) OVER SHEATHING. FORM WATER SHEDDING LAPS & SECURE AROUND ROUGH OPENING WITH STAPLES 9" MIN. AWAY FROM ROUGH OPENING SO THAT THE WRB CAN BE FOLDED BACK FOR WINDOW INSTALLATION

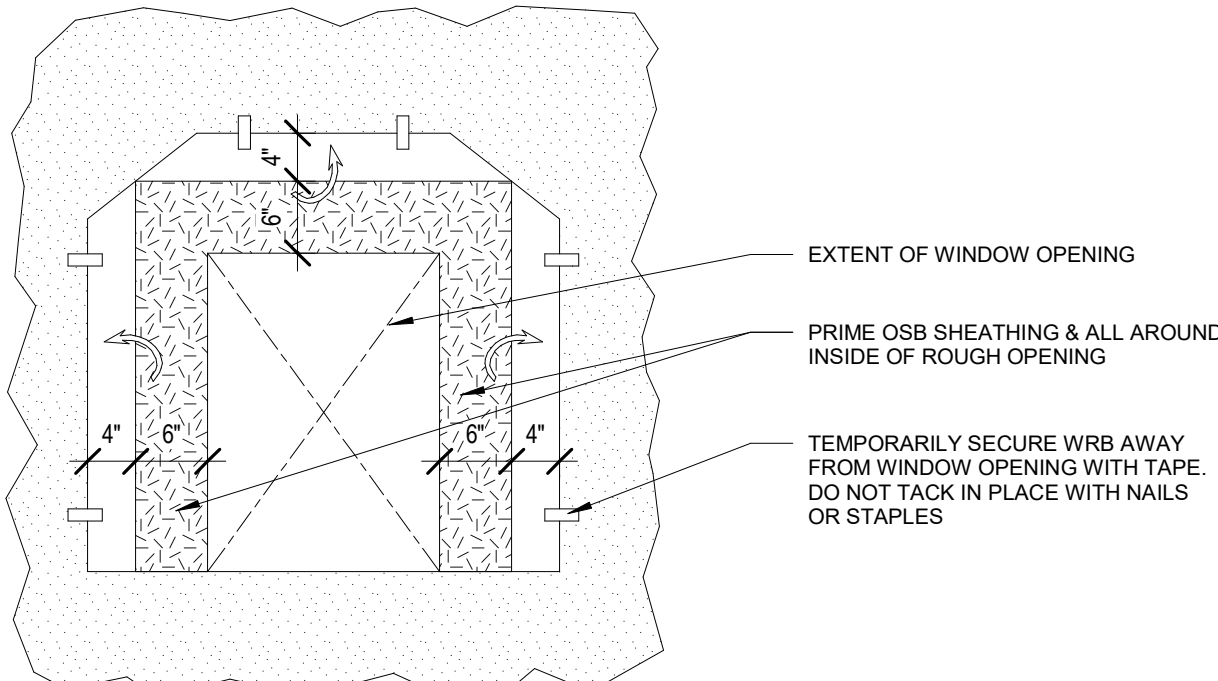


STEP 2

CUT WRB AT WINDOW OPENING 4" BEYOND THE ROUGH OPENING ON THE JAMS & HEAD.
TEMPORARILY TAPE WRB INTO PLACE.
PRIME OSB TO ENSURE ADHESION OF VYCOR TO OSB - USE 9M HIGH STRENGTH 90 ADHESIVE IF THE AIR TEMP IS BELOW 40 DEGREES, OR MFRS STANDARD PRIMER IF AIR TEMP IS ABOVE 40 DEGREES.

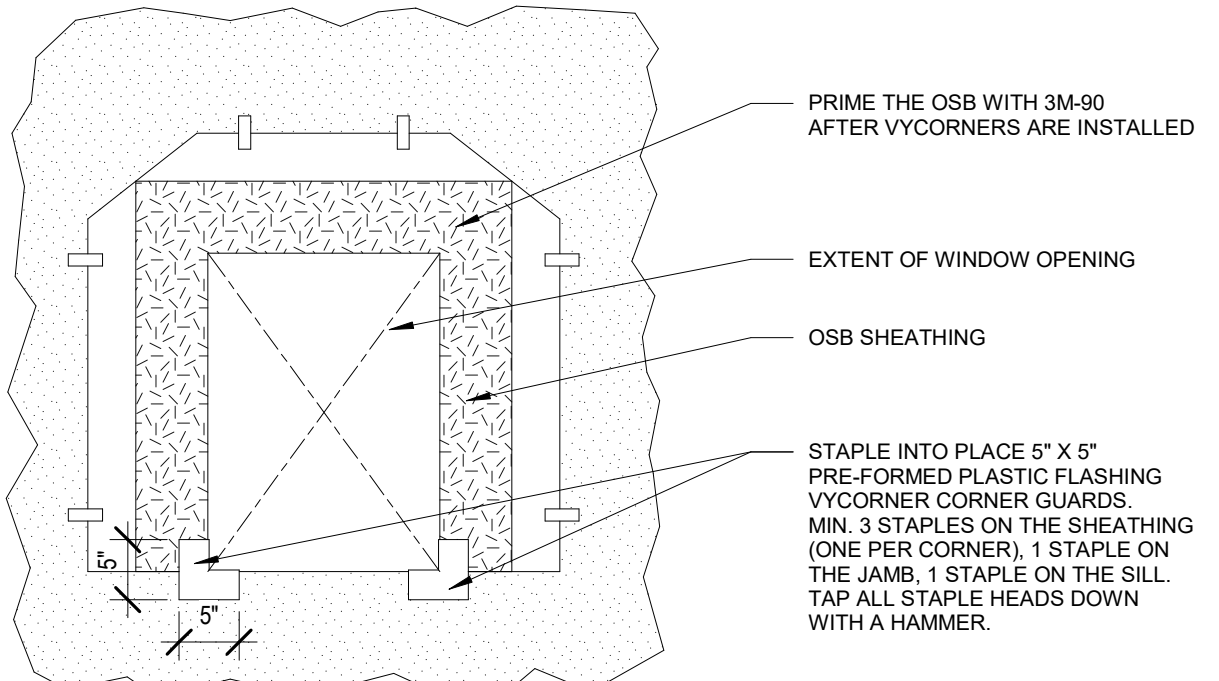


STEP 3

INSTALL "VYCORNER" CORNER GUARDS AT BOTH SILL CORNERS WITH STAPLES OR ROOFING NAILS PER MANUFACTURER'S INSTRUCTIONS.

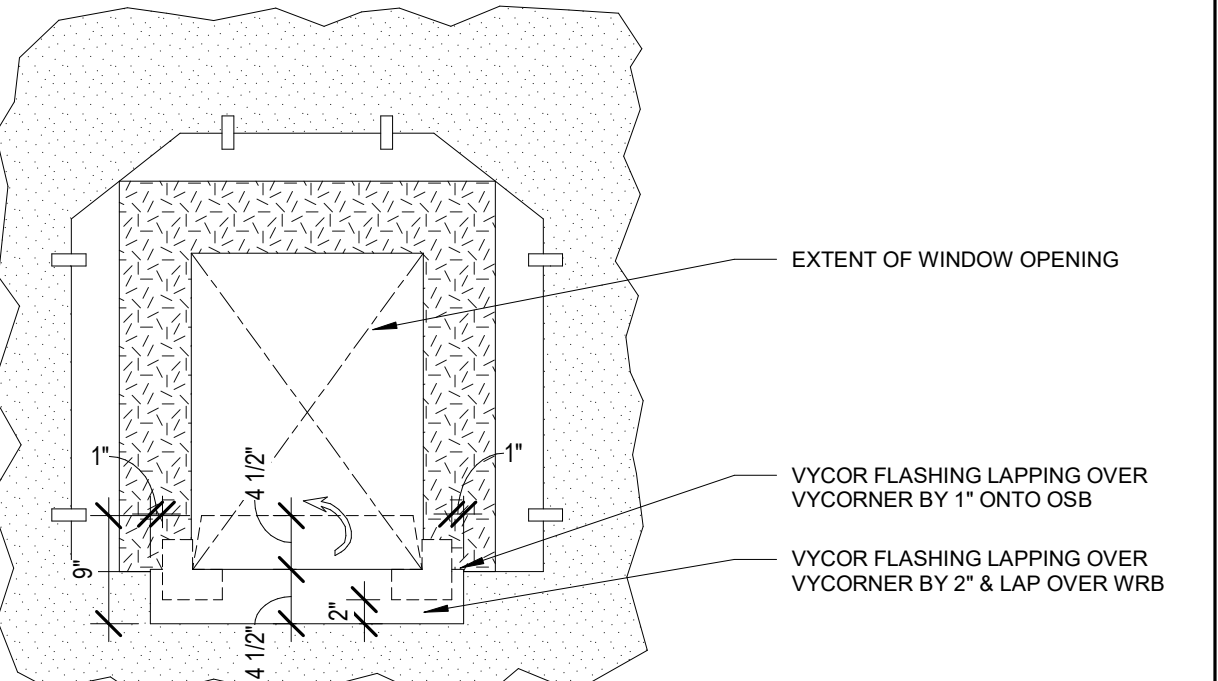


STEP 4

INSTALL 9" WIDE STRIP OF VYCOR FLASHING AT THE SILL & LAP OVER THE VYCORNERS & WRB BELOW BY 2". FLASHING TO EXTEND BEYOND VYCORNERS BY 1" ONTO OSB AT SIDES.
CUT HORIZONTAL SLITS IN FLASHING AND FOLD FLASHING ONTO SILL ROUGH OPENING, THEN FOLD UP WINDOW JAMBS.
RUB VYCOR FLASHING SMOOTH WITH CRAFT BACKING PAPER TO ENSURE COMPLETE BOND.

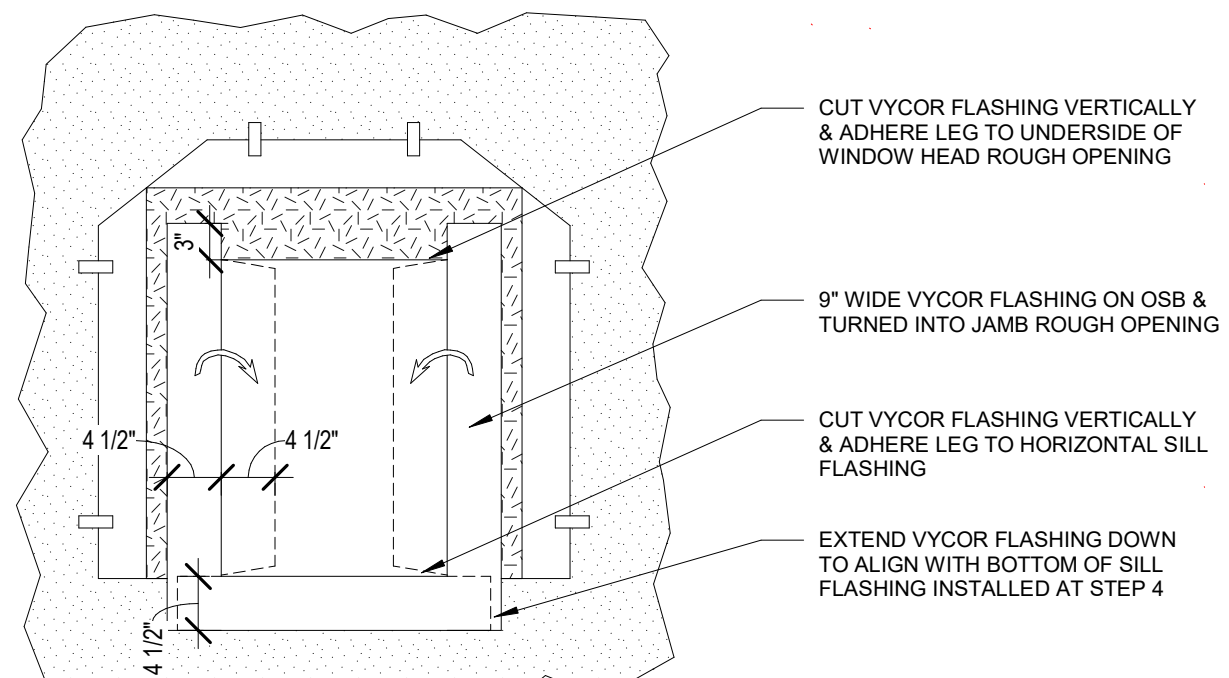


STEP 5

INSTALL 9" VYCOR FLASHING AT EACH JAMB SO THAT 4 1/2" CAN BE CUT VERTICALLY & FOLDED INTO THE JAMB. EXTEND THE FLASHING 3" BEYOND THE ROUGH OPENING AT THE SILL & HEAD.
RUB VYCOR FLASHING SMOOTH WITH CRAFT BACKING PAPER TO ENSURE COMPLETE BOND.

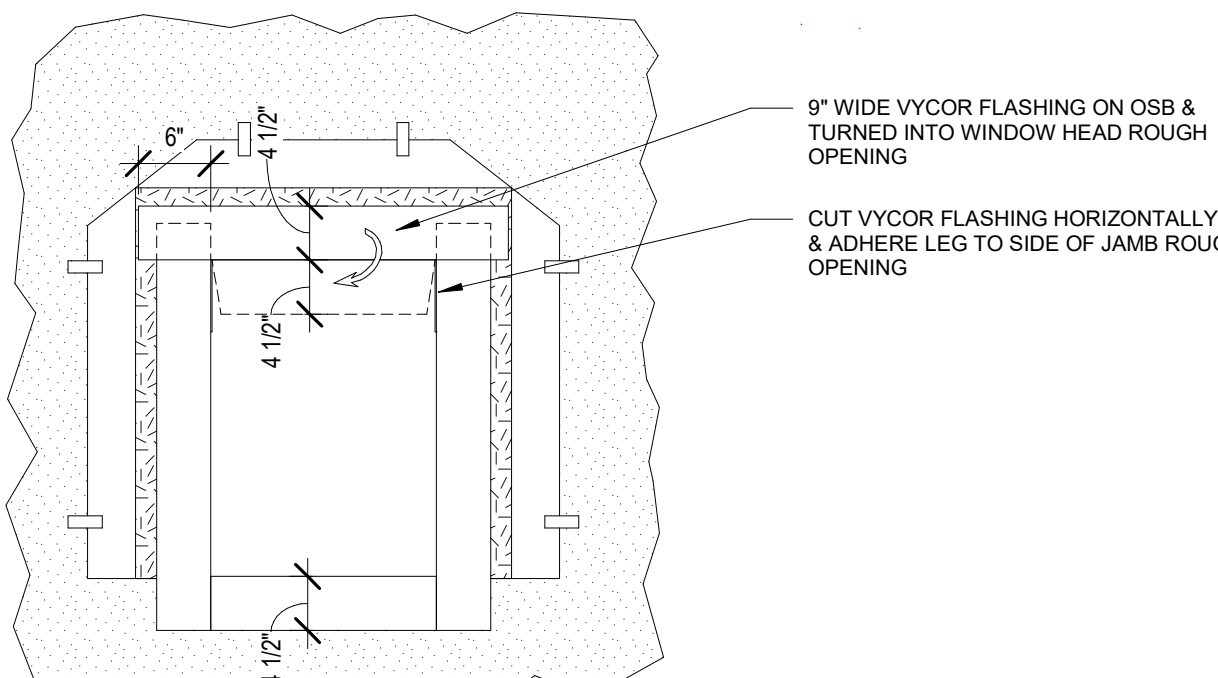


STEP 6

INSTALL 9" VYCOR FLASHING WINDOW HEAD SO THAT 4 1/2" CAN BE CUT HORIZONTALLY & FOLDED INTO THE JAMBS. EXTEND THE FLASHING 3" BEYOND THE ROUGH OPENING AT THE HEAD TO OVERLAP THE VERTICAL JAMB FLASHING.
RUB VYCOR FLASHING SMOOTH WITH CRAFT BACKING PAPER TO ENSURE COMPLETE BOND.

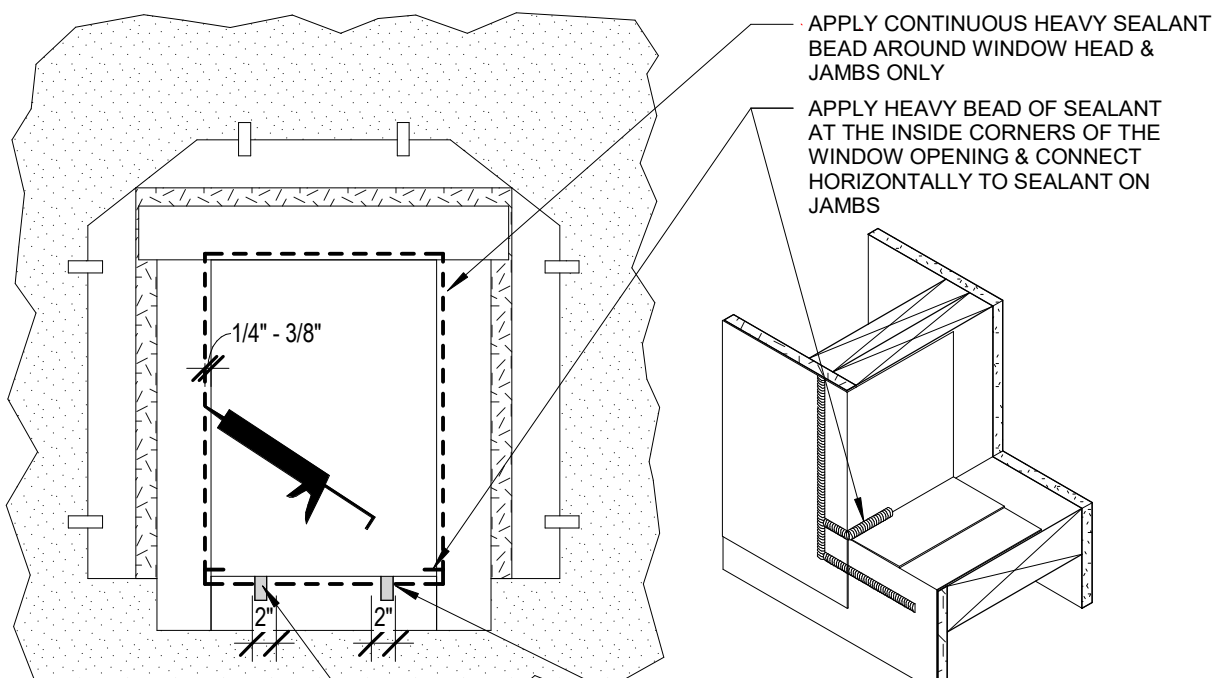


STEP 7

APPLY A HEAVY BEAD OF PROTECTO URETHANE SEALANT ONTO THE VYCOR FLASHING 1/4" FROM THE ROUGH OPENING UP THE JAMBS & ACROSS THE HEAD. PROVIDE SEALANT W/ (2) 2" WIDE SPACES FOR DRAINAGE.
APPLY HEAVY BEAD OF SEALANT AT THE INSIDE CORNERS OF THE SILL ROUGH OPENING BY 3" & CONNECT THIS SEALANT TO THE VERTICAL JAMB SEALANT WITH A HORIZONTAL BEAD.

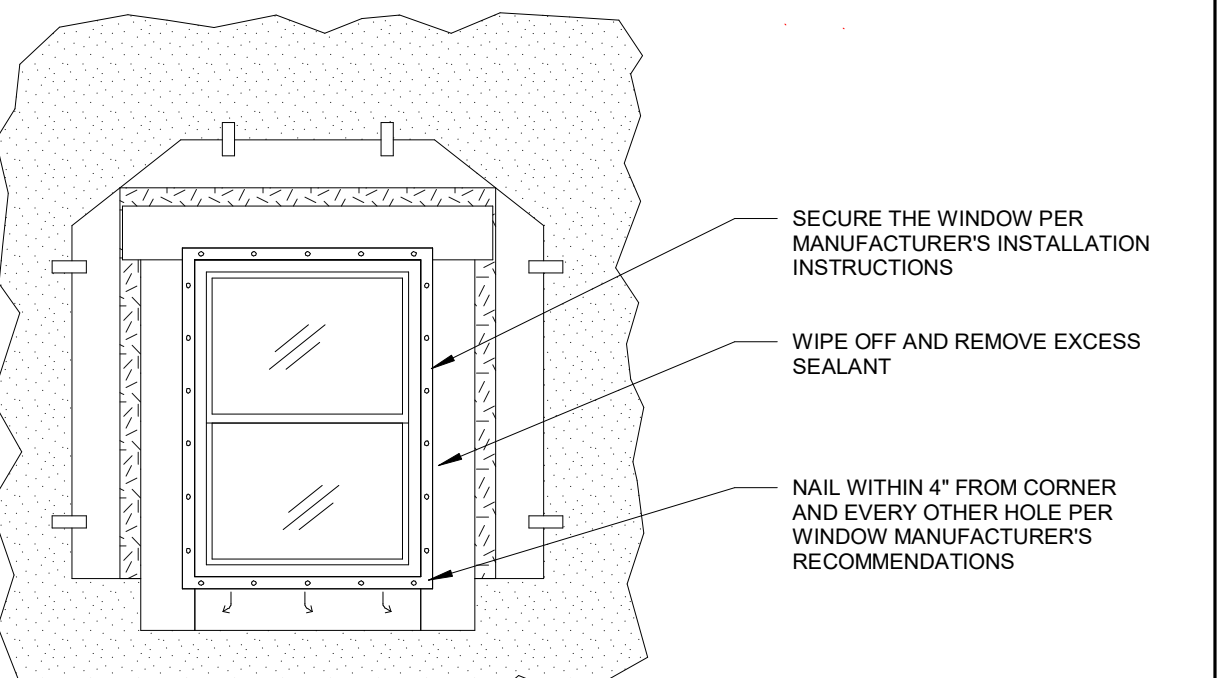


STEP 8

INSERT WINDOW INTO ROUGH OPENING & CENTER BETWEEN JAMBS. MAINTAIN A MAXIMUM 1/4" GAP BETWEEN THE BOTTOM OF THE WINDOW & THE SILL ROUGH OPENING.
SECURE THE WINDOW TO THE WALL PER MANUFACTURER'S INSTALLATION INSTRUCTIONS.

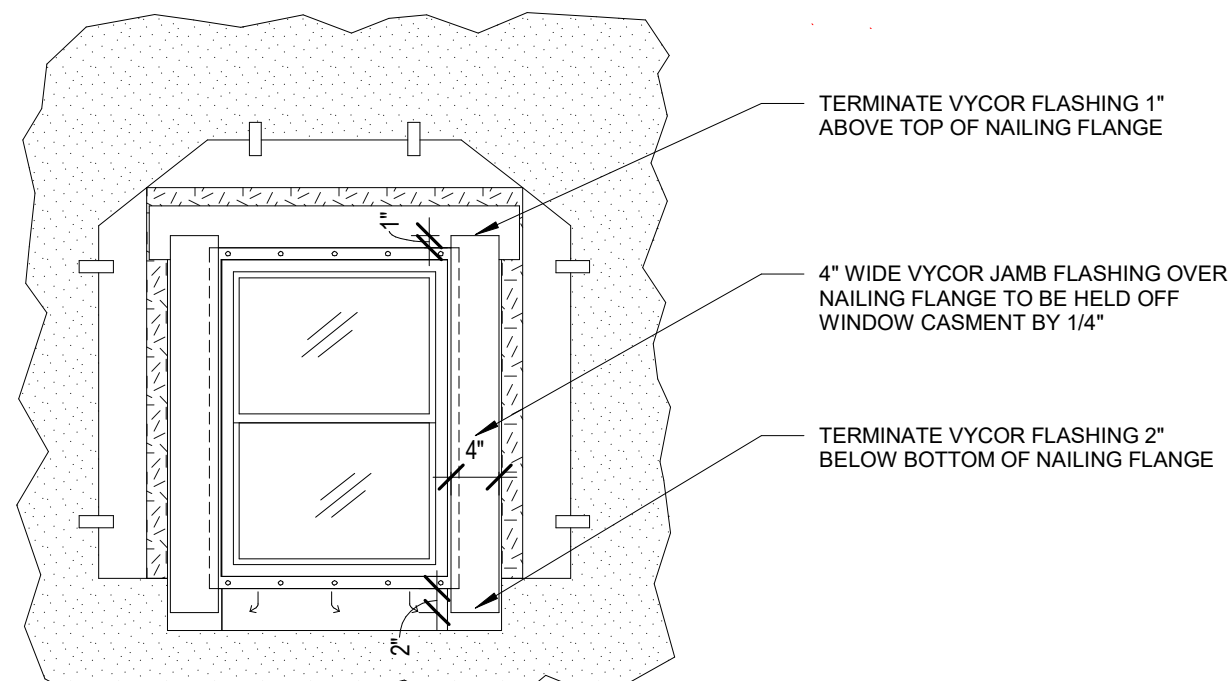


STEP 9

INSTALL 4" WIDE VYCOR FLASHING AT BOTH JAMBS & RUB VYCOR FLASHING SMOOTH WITH CRAFT BACKING PAPER TO ENSURE COMPLETE BOND. TERMINATE JAMB FLASHING 1" ABOVE & 2" BELOW WINDOW NAILING FLANGE.
HOLD FLASHING 1/4" OFF WINDOW CASEMENT ALL AROUND.

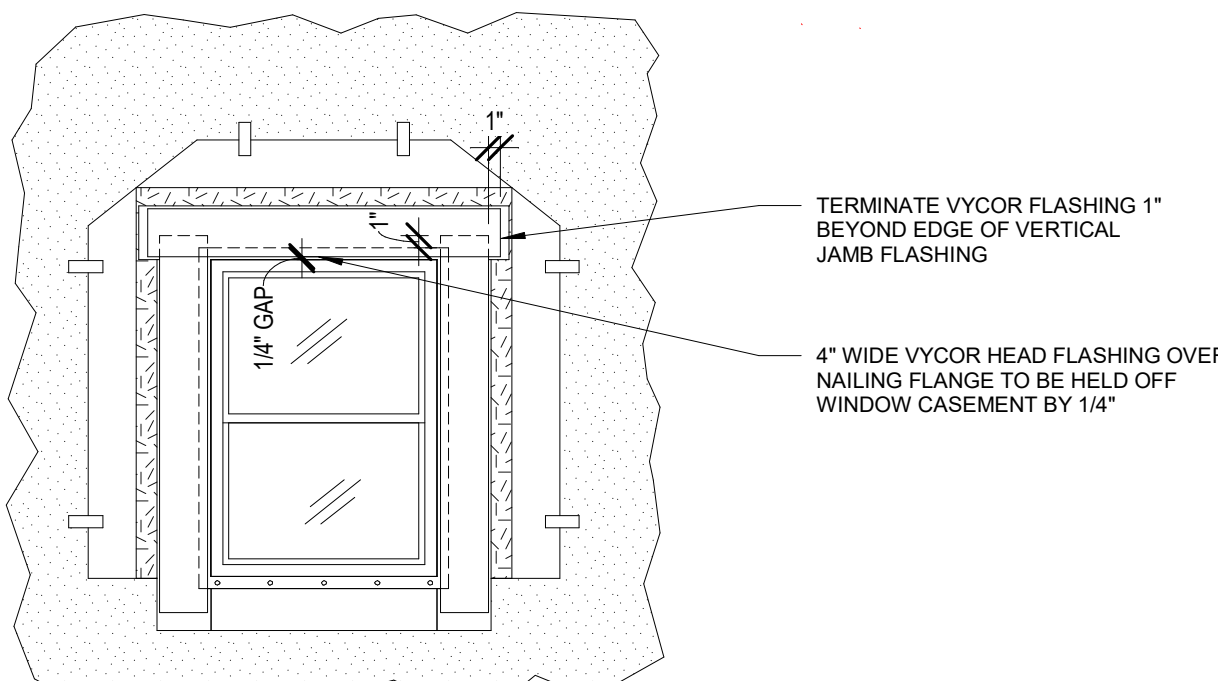


STEP 10

INSTALL 4" WIDE VYCOR FLASHING AT WINDOW HEAD & RUB VYCOR FLASHING SMOOTH WITH CRAFT BACKING PAPER TO ENSURE COMPLETE BOND. TERMINATE HEAD FLASHING 1" BEYOND EDGE OF VERTICAL JAMB FLASHING EACH SIDE OF WINDOW.
HOLD FLASHING 1/4" OFF WINDOW CASEMENT ALL AROUND.

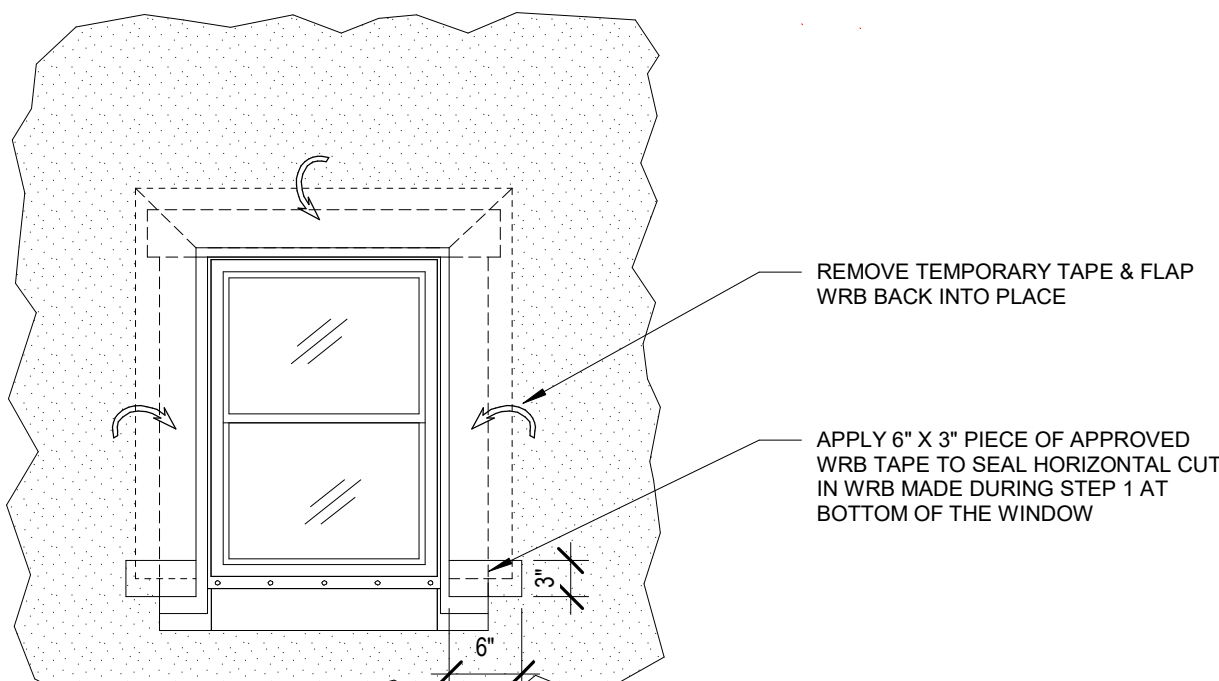


STEP 11

REMOVE TEMPORARY TAPE & FLAP WRB BACK OVER VYCOR FLASHING. USING WRB MFR APPROVED TAPE, TAPE THE BOTTOM HORIZONTAL CUTS IN THE WRB.

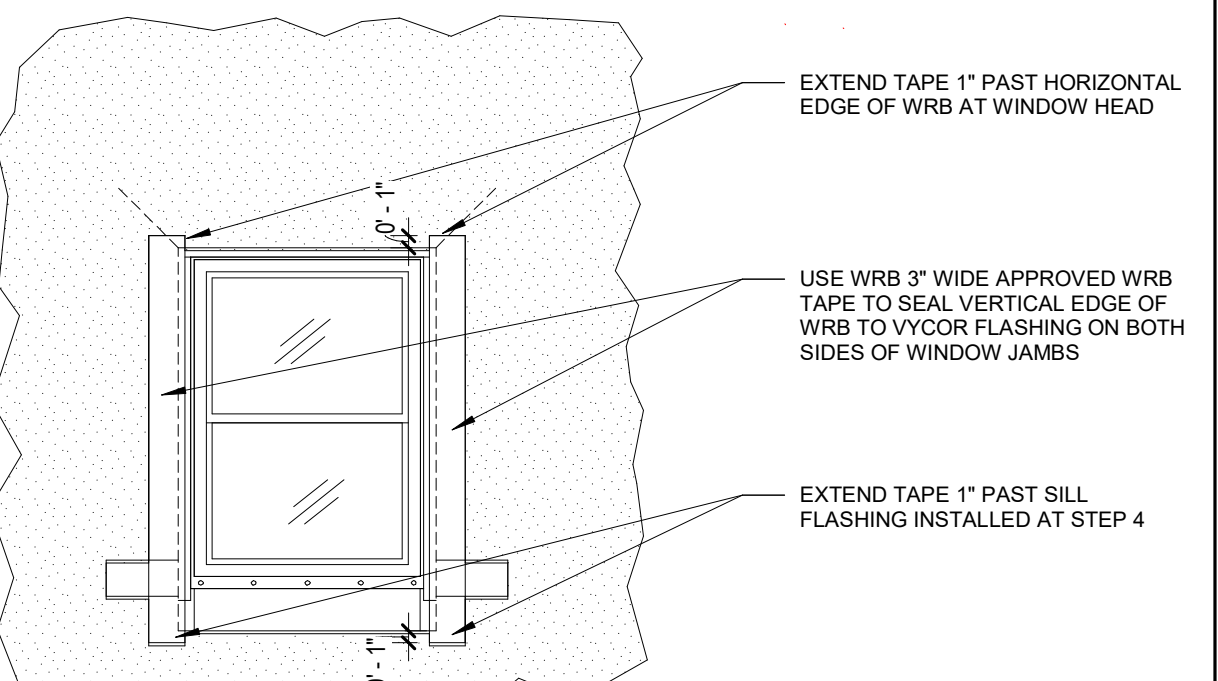


STEP 12

USING 3" WIDE WRB MFR APPROVED TAPE, TAPE THE VERTICAL JAMBS OF THE WRB TO THE VYCOR FLASHING. EXTEND THE TAPE 1" BELOW HORIZONTAL TAPE APPLIED DURING STEP 11, & BY 1" ABOVE WRB AT WINDOW HEAD.

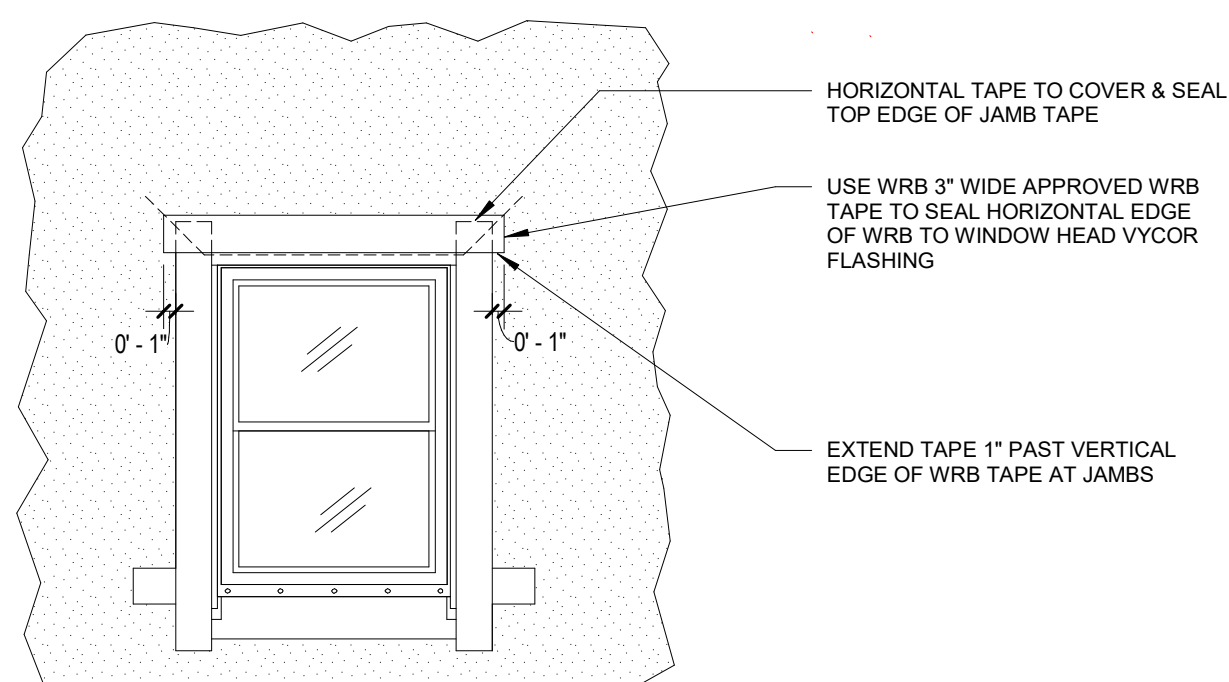


STEP 13

USING WRB MFR APPROVED TAPE, TAPE THE HORIZONTAL EDGE OF THE WRB AT THE WINDOW HEAD. TAPE TO EXTEND 1" BEYOND THE TAPE APPLIED TO THE JAMBS DURING STEP 12 & LAP OVER TOP EDGE OF JAMB TAPE ONTO WRB.

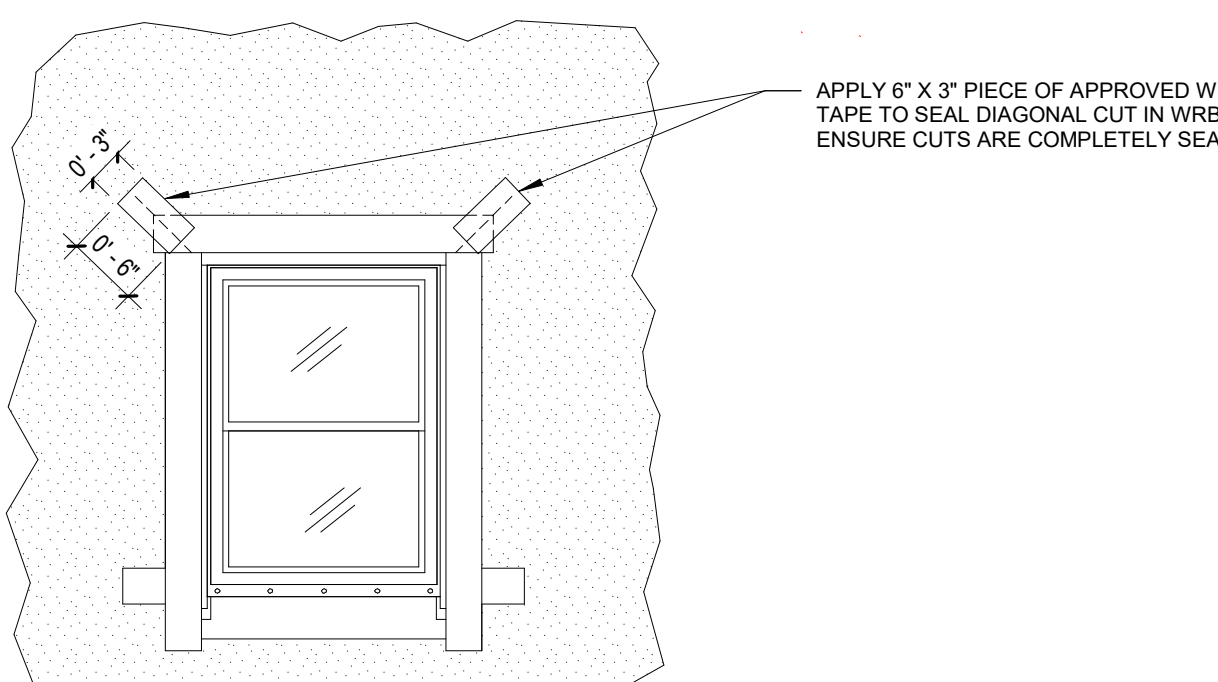


STEP 14

USING WRB MFR APPROVED TAPE, TAPE THE DIAGONAL CUTS IN THE WRB.

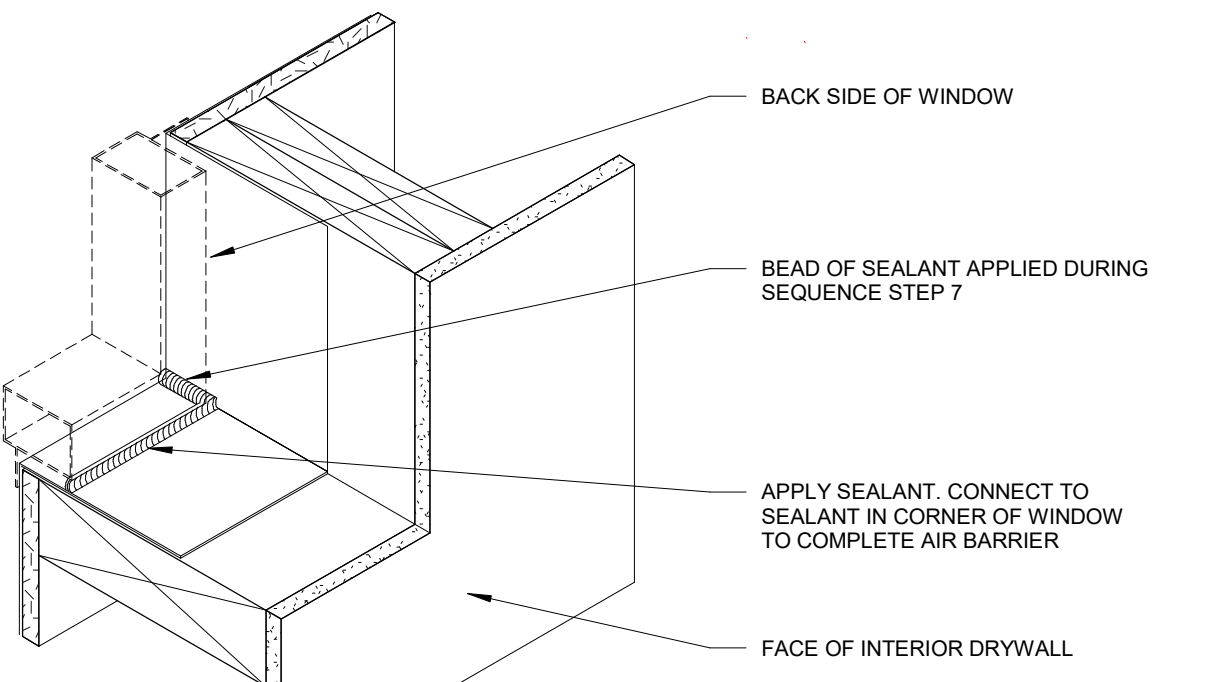

STEP 15

AFTER WINDOW INSTALLATION, PROVIDE SEALANT & BACKER ROD ALONG BOTTOM EDGE OF THE INSIDE FACE OF THE WINDOW FRAME. SEALANT TO CONNECT WITH SEALANT AT WINDOW CORNERS INSTALLED DURING STEP 7 TO COMPLETE THE WINDOW AIR BARRIER.

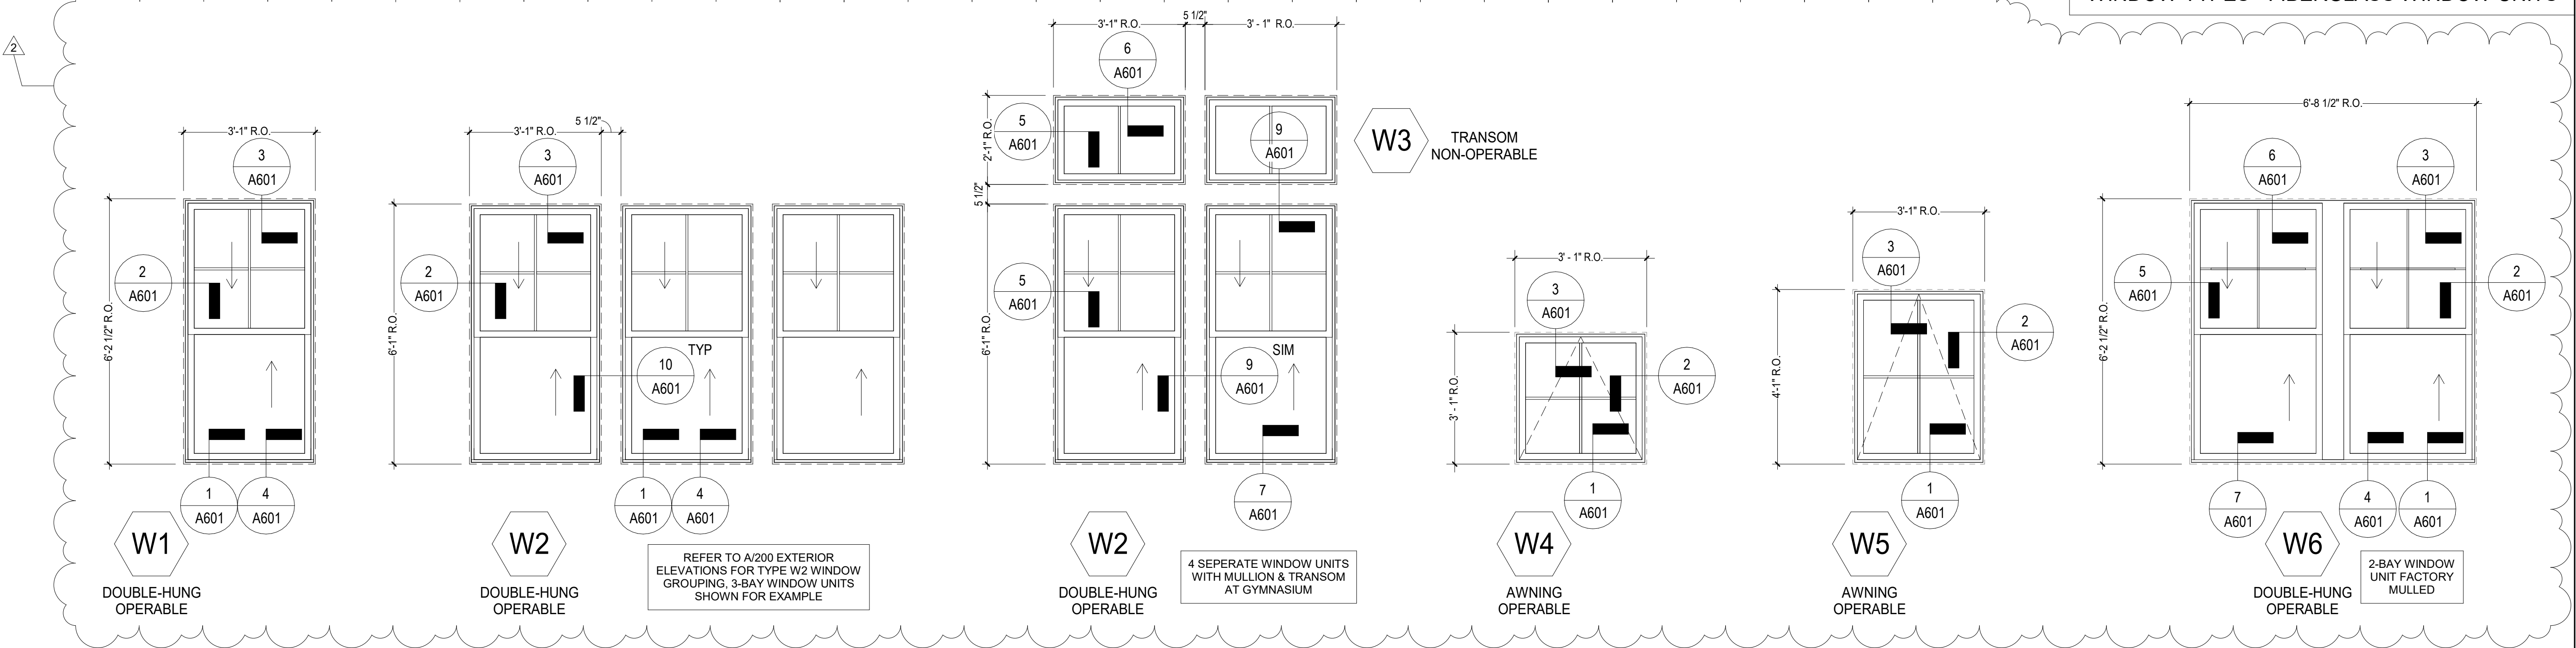

REVISIONS	
2 Addendum #2	08/03/2022

DRAWING TITLE

**Window Types &
Flashing Sequence**

DRAWING INFORMATION

07/22/22	DATE OF ISSUE
Construction Documents	DESCRIPTION
As indicated	Author
SCALE	DRAWN BY
3403.00	PROJECT #
PROJECT #	FILE NAME

DRAWING NUMBER


A602



$C_D = 3.0$
 $\phi_D = 0.069$
 $V = 70 \text{ KIPS}$
 EQUIVALENT LATERAL FORCE

LIGHT-FRAME WOOD WALLS SH
 WITH WOOD STRUCTURAL PANE
 RATED FOR SHEAR RESISTANCE

$R = 6.5$
 $C_d = 4.0$
 $\phi_D = 3.0$
 $C_s = 0.032$
 $V = 15 \text{ KIPS}$
 EQUIVALENT LATERAL FORCE

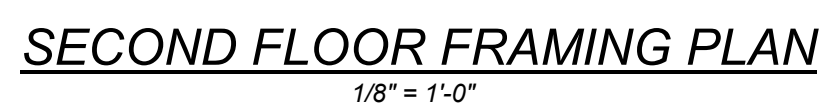


- ARCHITECT**
bhda
Bargmann Architects + Archetype, Inc.
9 Channel Center Street, Suite 300
Boston, MA 02210
(617) 350-0450
- PROJECT NAME**
Pembroke
Community Center
128 Center Street
Pembroke, MA 02359
- CIENT**
Town of Pembroke
MA
100 Center Street
Pembroke, MA 02359
- PROJECT TEAM**
Civil Engineer
Meritt Engineers & Land Surveyors
427 Columbia Road
Haverhill, MA 02329
(781) 825-8200
- Landscape Architect**
Kyle Clark Landscape Architecture, Inc.
85 Broadland Street, Suite 202
Boston, MA 02108
(617) 451-1018
- Structural Engineer**
Foley Ball Roberts & Associates, Inc.
2150 Washington Street
Newton, MA 02452
(617) 527-5600
- ME/PE/P Engineer**
Allied Consulting Engineering Services
235 Littleton Road, Suite 5
Westford, MA 01886
(978) 443-7886
- Kitchen Consultant**
Crawford McGrath Associates
61 West Main Street
Georgetown, MA 01833
(978) 352-8500
- Elevator Consultant**
B Squared Engineering
169 Mill Brook Road
Lynn, MA 01901
(201) 989-9029
- Audio Visual Consultant**
XXXXXXXXXXXX
XXXXXXXXXXXXXXXXXXXX
XXXXXXXXXXXX
- Code Consultant**
Commercial Construction Consulting, Inc.
217 Congress Street
Boston, MA 02210
(317) 330-9230
- Geotechnical Engineer**
McKirdie Gannon Associates, Inc.
300 Oak Street, Suite 450
Pembroke, MA 02359
(781) 825-0040

DRAWING TITLE

**Second Floor
Framing Plan**

DRAWING NUMBER

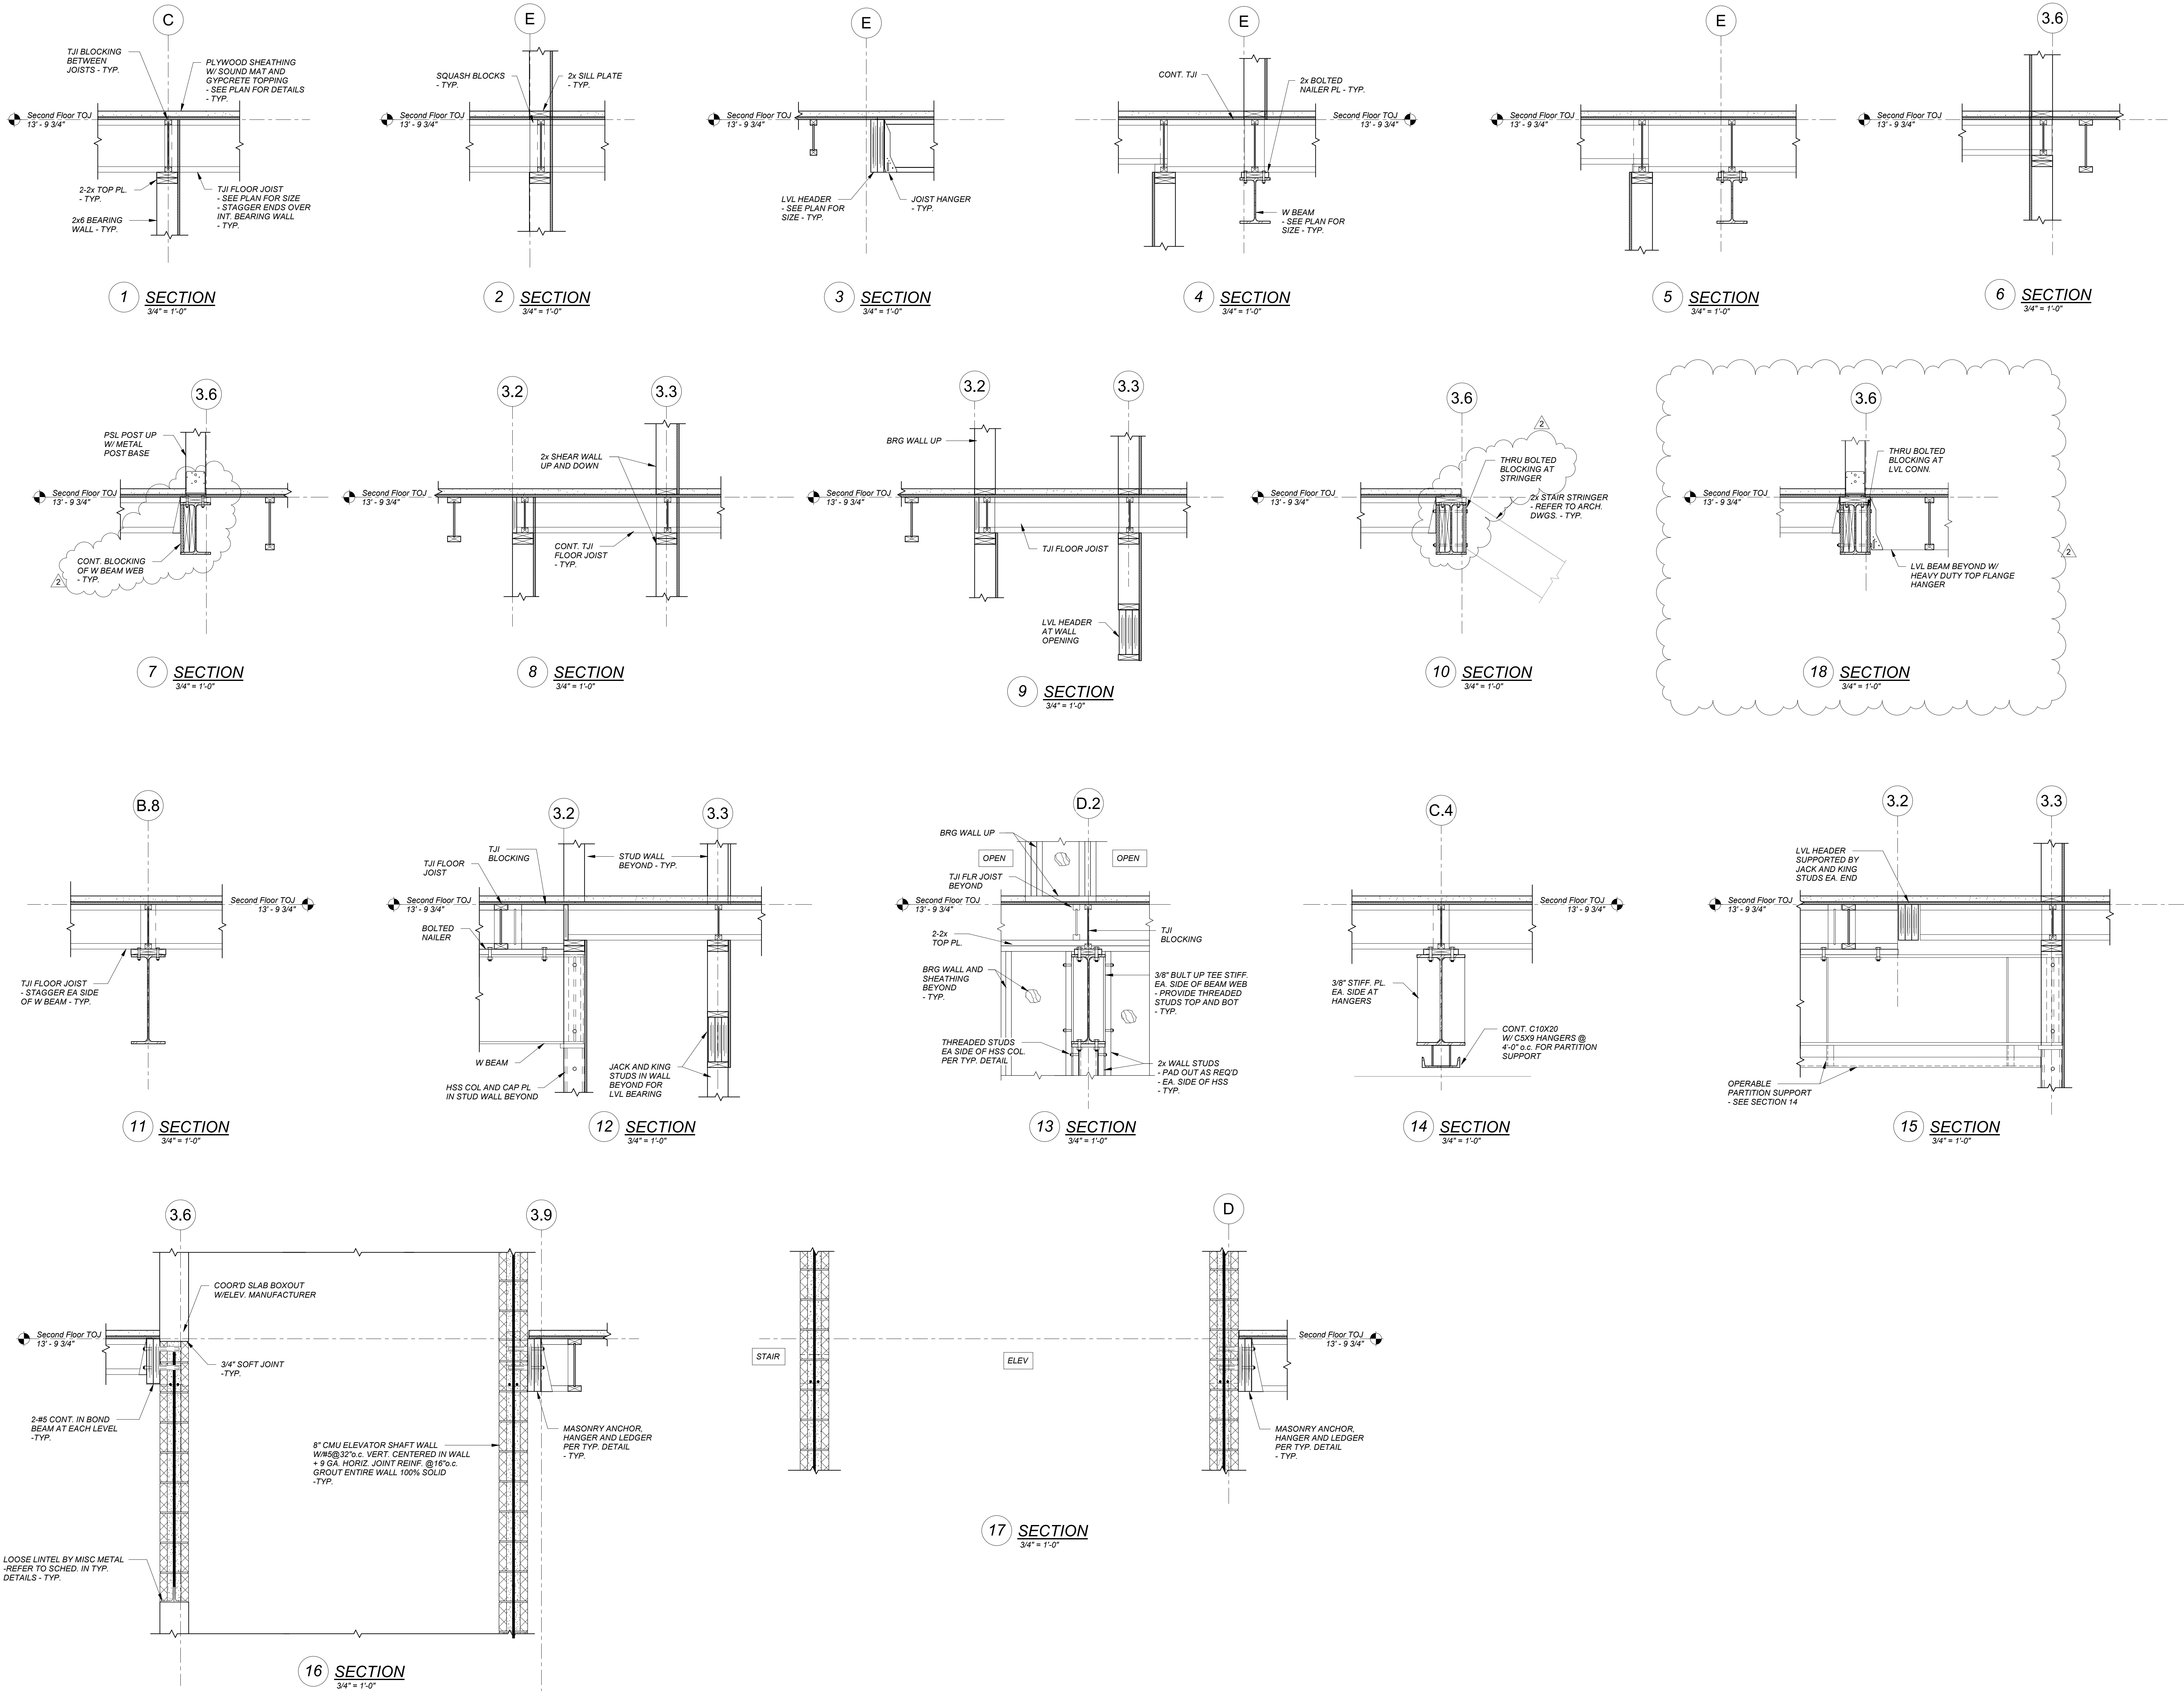

PROJECT NAME
Pembroke Community Center
128 Center Street
Pembroke, MA, 02359

CLIENT
Town of Pembroke MA
100 Center Street
Pembroke, MA, 02359

PROJECT TEAM
Civil Engineer
Meritt Engineers & Land Surveyors
427 Columbia Road
Haverhill, MA, 02339
(817) 527-9500
Landscape Architect
Kyle Zick Landscape Architecture, Inc.
36 Bromfield Street, Suite 202
Boston, MA, 02108
(617) 451-1018
Structural Engineer
Foley Buhl Roberts & Associates, Inc.
2150 Washington Street
Newton, MA, 02462
(817) 527-9500
MEP/FP Engineer
Allied Consulting Engineering Services
235 Littleton Road, Suite 5
Westford, MA, 01886
(978) 443-7888
Kitchen Consultant
Crabtree McGrath Associates
161 West Main Street
Georgetown, MA, 01833
(978) 352-8500
Elevator Consultant
B Squared Engineering
169 Mill Brook Road
Stamford, CT, 06902
(203) 989-9029
Audio Visual Consultant
XXXXXXXXXXXX
XXXXXXXXXXXXXXXXXXXX
XXXXXXXXXXXXXXXXXXXX
XXXXXXXXXXXX
Code Consultant
Commercial Construction Consulting, Inc.
313 Congress Street
Boston, MA, 02210
(617) 330-9390
Geotechnical Engineer
McArdle Gannon Associates, Inc.
300 Oak Street, Suite 460
Pembroke, MA, 02359
(817) 825-0040

REVISIONS	
2 Addendum #2	08/03/2022

DRAWING TITLE	
Framing Sections II	

DRAWING INFORMATION	
07/22/22	
DATE OF ISSUE	
Construction Documents	
DESCRIPTION	
3/4" = 1'-0"	Author
3403.00	DRAWN BY
PROJECT #	FILE NAME

DRAWING NUMBER	
S502	


C:\Users\CEC\Documents\2021\184 Pembroke CC 02021_Lfp_s502.dwg
8/1/2022 3:05:26 PM
Author

Copyright BHA, Inc. V.2.1

DRAWING NUMBER



Z:\Shared\Projects - (user)\2021 (Rack)\1188-89-61184\E100\1184 - E100 First Floor Powering PLOTTED - Aug 03, 2022 - 12:24am

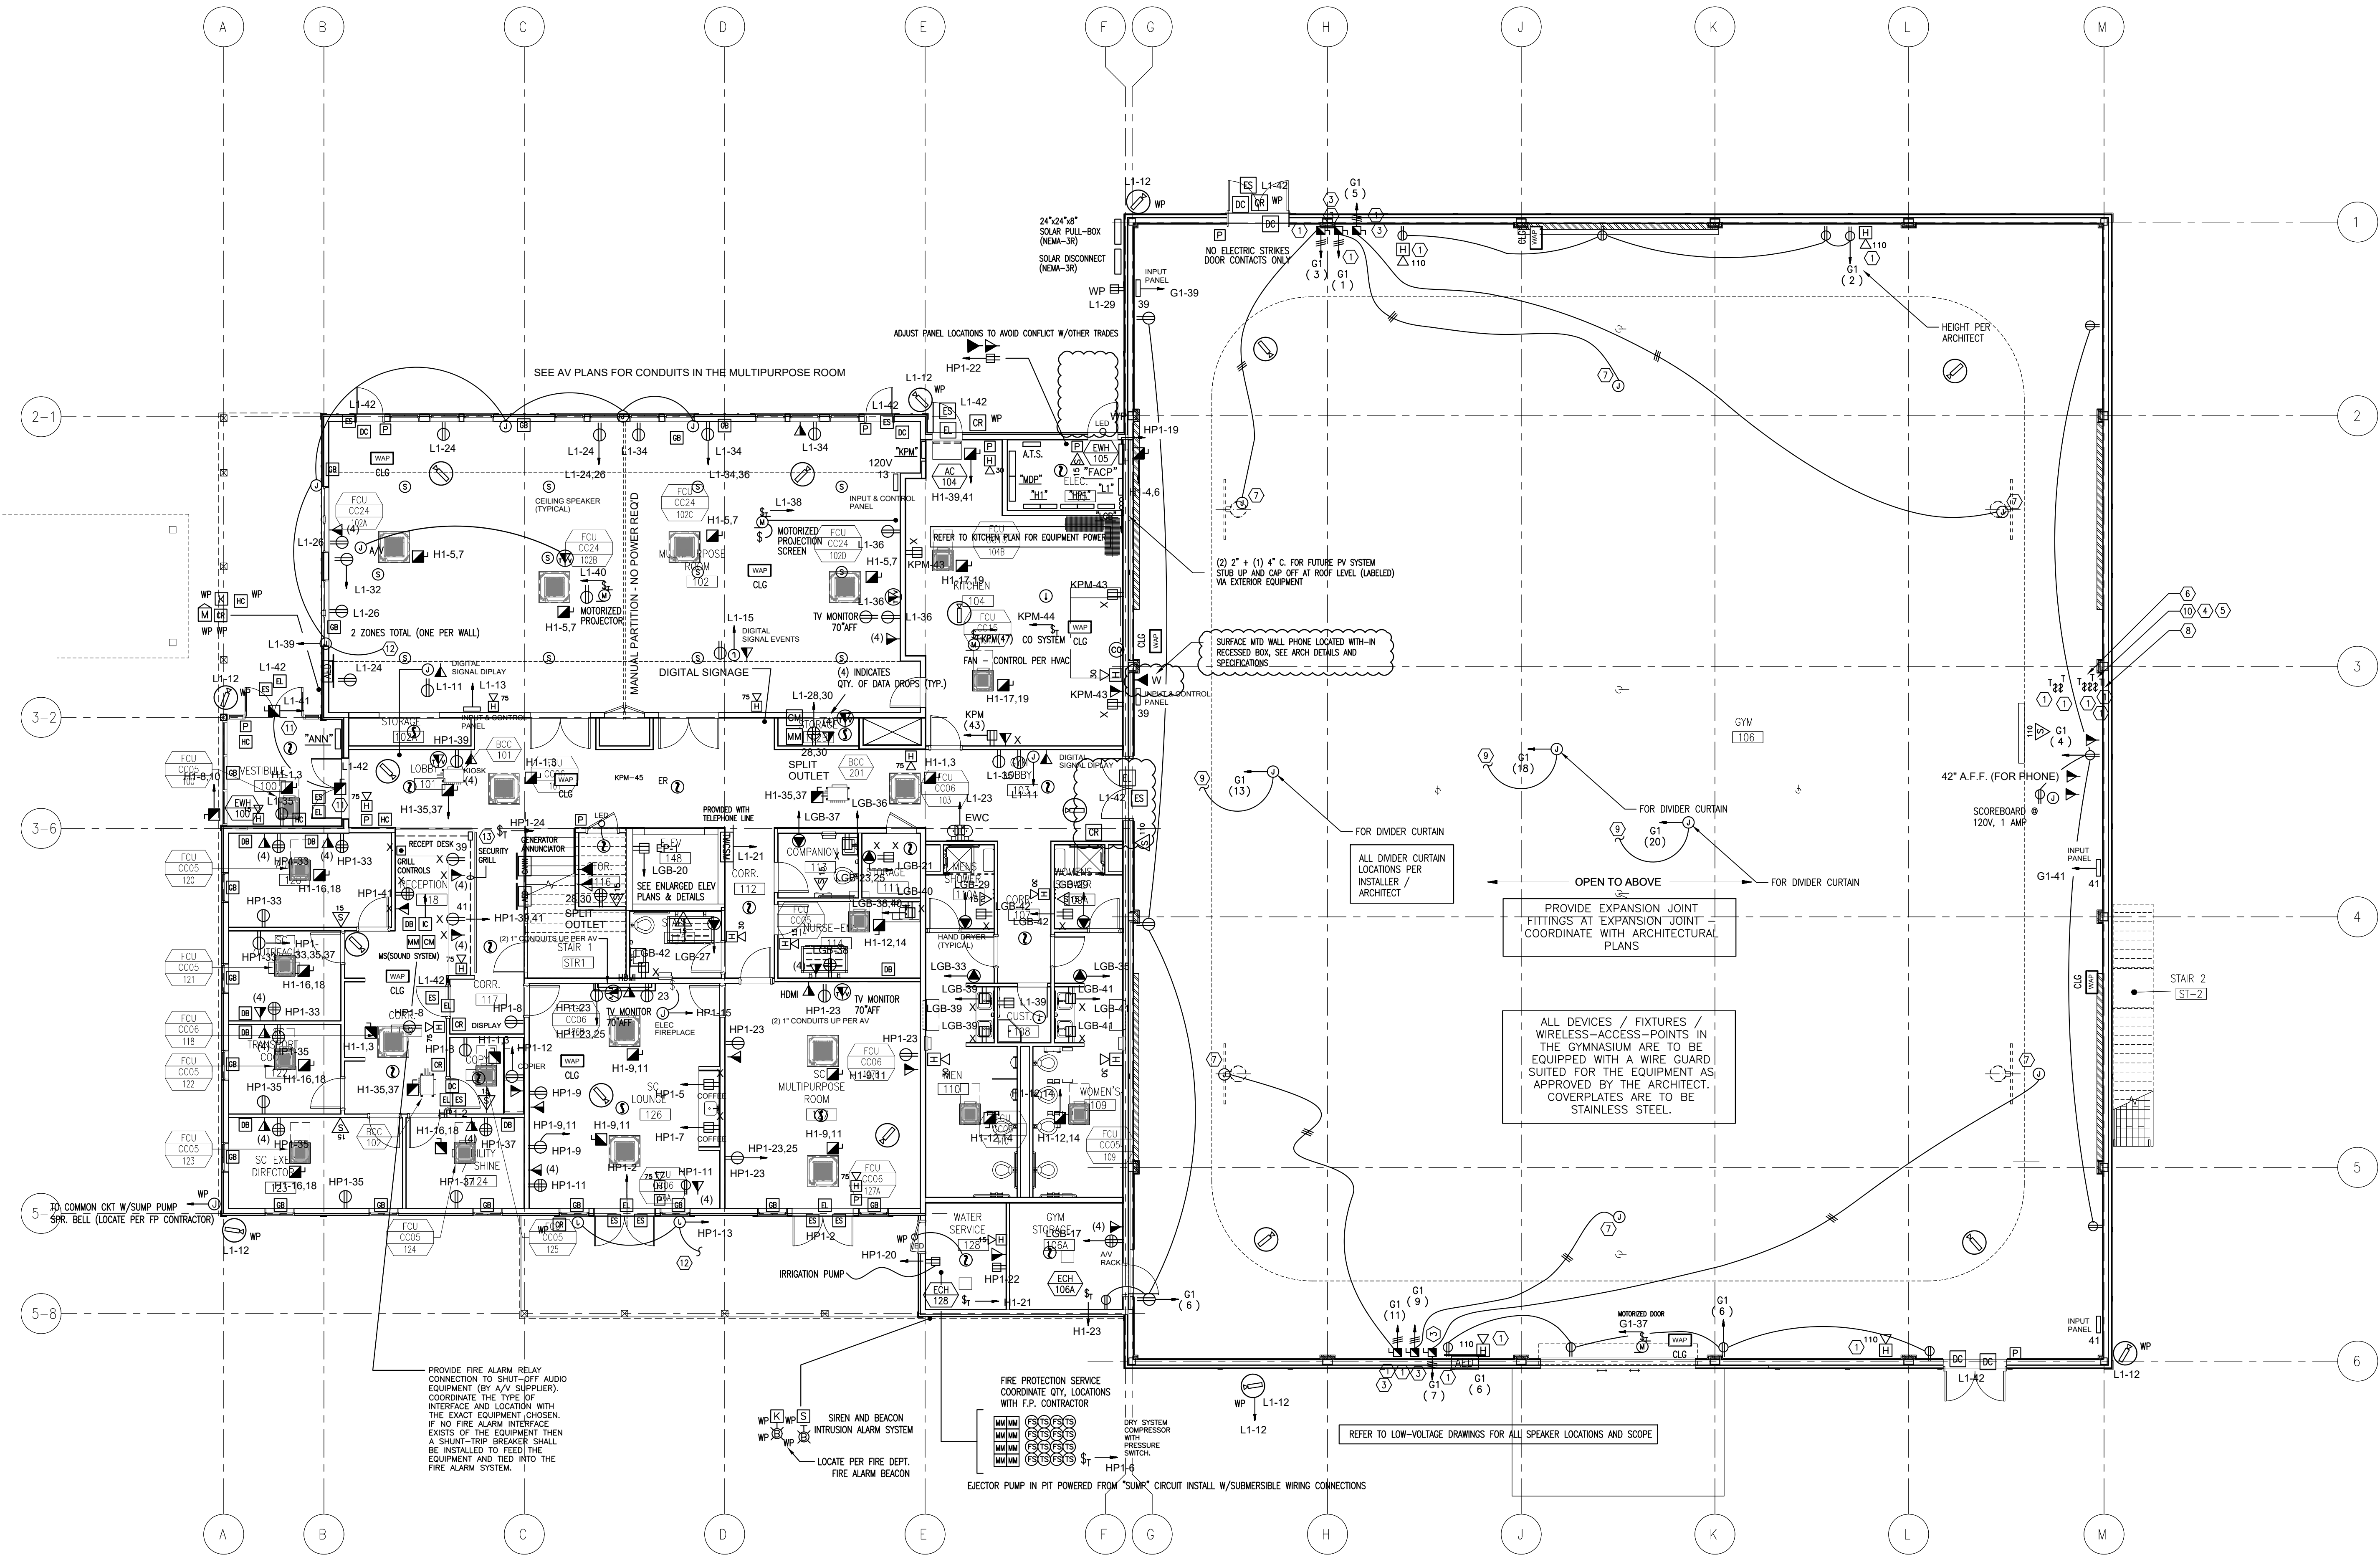

1 First Floor Plan
1/8" = 1'-0"

POWER NEW WORK PLAN GENERAL NOTES:

1. THE ELECTRICAL CONTRACTOR IS TO PROVIDE INTERLOCKING CONNECTIONS FOR ALL HVAC EQUIPMENT AS REQUIRED. REFER TO THE MECHANICAL SCHEDULES FOR EXACT INTERLOCKING INFORMATION. THE ELECTRICAL CONTRACTOR IS TO COORDINATE THE EXACT LOCATION OF ALL HVAC EQUIPMENT, ETC. PRIOR TO INSTALLATION.
2. THE ELECTRICAL CONTRACTOR IS TO COORDINATE THE EXACT LOCATION OF ALL MECHANICAL AND PLUMBING SITE SWITCHES PRIOR TO INSTALLATION.
3. THE EXACT MOUNTING HEIGHTS FOR ALL DEVICES IS TO BE COORDINATED WITH THE CABINETS CHOSEN. COMPUTER OUTLETS ARE TO BE MOUNTED BELOW THE LEVEL OF THE WORK SURFACE. T.V. OUTLETS (BOTH POWER AND CATV) ARE TO BE MOUNTED BEHIND THE T.V. (WALL) OR CENTERED UNDER THE GROMIT (FLOOR).
4. ALL DISCONNECTS FOR MECHANICAL UNITS ARE TO BE MOUNTED SECURELY TO THE FLOOR/STRUCTURE. THE ELECTRICAL CONTRACTOR IS TO PROVIDE AND INSTALL UNISTRUT AND MOUNTING HARDWARE AS REQUIRED TO MOUNT THE DISCONNECTS.
5. THE ELECTRICAL CONTRACTOR IS TO COORDINATE THE EXACT RECEPTACLE TYPE AND VOLTAGE FOR ALL EQUIPMENT WITH THE RESPECTIVE EQUIPMENT SUPPLIER PRIOR TO INSTALLATION.
6. CENTER LIGHTS, OUTLETS, DEVICES ON LENGTHS OF WALLS OR BETWEEN WINDOWS.
7. STACK DEVICES, OUTLETS AND SWITCHES WHENEVER POSSIBLE. SWITCHES, OUTLETS AND DEVICES SHALL BE CLEAR OF DOOR SWINGS.
8. ALL PANEL TUBS LOCATED IN DEMISING WALLS SHALL BE RATED TO MATCH THE WALL ASSEMBLY. COORDINATE METHOD OF RATING WITH THE G.C.
9. AT EACH FSD (FIRE-SMOKE DAMPER) LOCATION, PROVIDE CONTROL AND MONITOR MODULES, DUCT SMOKE DETECTOR WITH REMOTE TEST STATION, ACCESSIBLE, WALL MOUNTED 6" BELOW FINISHED CEILING.
10. PROVIDE #10AWG FOR ALL 120VOLT CIRCUITS THAT EXCEED 120 FEET IN LENGTH FROM MIDDLE OF BRANCH CIRCUIT.
11. INCLUDE ALL WIRING (INCLUDING TO SWITCHES) FOR ALL DOOR OPERATORS - COORDINATE WITH THE DOOR INSTALLER AT THE TIME OF INSTALLATION. WIRE FROM THE CIRCUITS IN THE MDF ROOM AND INCLUDE TRANSFORMERS FOR LOW VOLTAGE AS NECESSARY.
13. THE ELECTRICAL CONTRACTOR SHALL REVIEW AND INCLUDE ALL NECESSARY SCOPE AS LISTED TO BE PERFORMED BY THE G.C./E.C. ON THE SECURITY/HARDWARE/A-V AND TEL-DATA PLANS.
14. CLARIFICATION IS TO BE OBTAINED PRIOR TO BID IF ANY PORTION OF THE SCOPE IS UNCLEAR.

POWER NEW WORK PLAN KEYNOTES:

1. THIS DEVICE / FIXTURE IS TO BE EQUIPPED WITH A WIRE GUARD AS APPROVED BY THE ARCHITECT.
2. FIELD COORDINATE THE ROUTING OF CONDUIT TO THE FLOOR BOXES. ALL CONDUIT IS TO BE CONCEALED. THE ELECTRICAL CONTRACTOR IS TO CLOSELY COORDINATE THE FINISHING OF WALLS, FLOOR, ETC. WITH THE GENERAL CONTRACTOR. IN ADDITION TO THE POWER CIRCUIT SHOWN, ONE (1) 1" CONDUIT IS TO BE RUN TO EACH BOX TO RUN DATA CABLES.
3. THE ELECTRICAL CONTRACTOR IS TO PROVIDE POWER TO THE BASKETBALL GOALS AS REQUIRED. INCLUDE THE INSTALLATION OF ALL ASSOCIATED CONTROLS. THE CONTRACTOR IS TO VERIFY THE DISCONNECT MOUNTING HEIGHT, POWER REQUIREMENTS, AND CONNECTION POINTS AND ADJUST ACCORDINGLY.
4. THE ELECTRICAL CONTRACTOR IS TO WIRE THIS SWITCH TO CONTROL ALL ELECTRICALLY OPERATED BLINDS/SHADES - PROVIDE AND INSTALL A CONTACTOR TO ACCOMPLISH THIS.
5. CONNECT THIS CIRCUIT TO THE ELECTRICALLY OPERATED BLINDS/SHADES AND CONTROL PER UPPER FLOOR PLAN. COORDINATE THE EXACT POINT OF CONNECTION WITH THE BLIND/SHADE INSTALLER IN THE FIELD. EXTEND THE WIRE AND CONDUIT AS NECESSARY, TO THE POINT OF CONNECTION.
6. THE ELECTRICAL CONTRACTOR IS TO WIRE THIS SWITCH TO CONTROL ALL ELECTRICALLY OPERATED GOALS - PROVIDE AND INSTALL A CONTACTOR TO ACCOMPLISH THIS.
7. CONNECT THIS CIRCUIT TO THE ELECTRICALLY OPERATED GOALS AND CONTROL PER KEYNOTES. COORDINATE THE EXACT POINT OF CONNECTION WITH THE GOAL INSTALLER IN THE FIELD. EXTEND THE WIRE AND CONDUIT AS NECESSARY, TO THE POINT OF CONNECTION.
8. THE ELECTRICAL CONTRACTOR IS TO WIRE THIS SWITCH TO CONTROL ALL ELECTRICALLY OPERATED DIVIDER CURTAINS.
9. CONNECT THIS CIRCUIT TO THE ELECTRICALLY OPERATED DIVIDER CURTAINS AND CONTROL PER KEYNOTES. COORDINATE THE EXACT POINT OF CONNECTION WITH THE CURTAIN INSTALLER IN THE FIELD. EXTEND THE WIRE AND CONDUIT AS NECESSARY, TO THE POINT OF CONNECTION.
10. THERE ARE TO BE A TOTAL OF TWO (2) BLINDS/SHADES SWITCHES - ONE PER CIRCUIT/ZONE. EACH SWITCH IS TO BE "KEYED" TYPE AND BE LABELED APPROPRIATELY TO INDICATE THE APPLICABLE ZONE - USE MICARTA PLATE LABELING.
11. WIRE ALL ASPECTS OF THE HANDICAP DOOR OPERATOR SYSTEM (4 DOORS).
12. CONNECT THIS CIRCUIT TO THE ELECTRICALLY OPERATED BLINDS/SHADES AND CONTROL PER KEYNOTES. COORDINATE THE EXACT POINT OF CONNECTION WITH THE BLIND/SHADE INSTALLER IN THE FIELD. EXTEND THE WIRE AND CONDUIT AS NECESSARY, TO THE POINT OF CONNECTION.
13. CONNECT THIS CIRCUIT TO THE ELECTRICALLY OPERATED SECURITY GRILL AND CONTROL PER KEYNOTES. COORDINATE THE EXACT POINT OF CONNECTION WITH THE GRILL INSTALLER IN THE FIELD. EXTEND THE WIRE AND CONDUIT AS NECESSARY, TO THE POINT OF CONNECTION, INCLUDING OPEN/CLOSE PUSHBUTTON CONTROLS AND EMERGENCY EGRESS PULL HANDLE MANUAL RELEASE STATION.

ARCHITECT

bh+a

Bergmann Hendrie + Archetype, Inc.
9 Channel Center Street, Suite 300
Boston, MA 02210
(617) 350-0450

PROJECT NAME

Pembroke
Community Center

128 Center Street
Pembroke, MA, 02359

CLIENT

Town of Pembroke
MA

100 Center Street
Pembroke, MA, 02359

PROJECT TEAM

Civil Engineer
Merrill Engineers & Land Surveyors

427 Columbia Road
Haverhill, MA, 02309
(781) 826-9200

Landscape Architect
Kyle Zick Landscape Architecture, Inc.

36 Bromfield Street, Suite 202
Boston, MA, 02108
(617) 451-1018

Structural Engineer

Foley Buhl Roberts & Associates, Inc.
2155 Washington Street
Newton, MA, 02462
(617) 527-9600

ME/PFP Engineer

Allied Consulting Engineering Services
235 Littleton Road, Suite 5
Westford, MA, 01886
(978) 443-7888

Geotechnical Engineer

McAfee Gannon Associates, Inc.
300 Oak Street, Suite 460
Pembroke, MA, 02359
(781) 826-0040

Elevator Consultant

B Squared Engineering
169 Mill Brook Road
Stamford, CT 06902
(203) 988-9029

REVISIONS

1.	ADDENDUM #2 08/03/2022

DRAWING TITLE


Electrical First
Floor Plan
Power & Fire
Alarm


DRAWING INFORMATION


07/20/22	DATE OF ISSUE

DRAWING NUMBER


E100

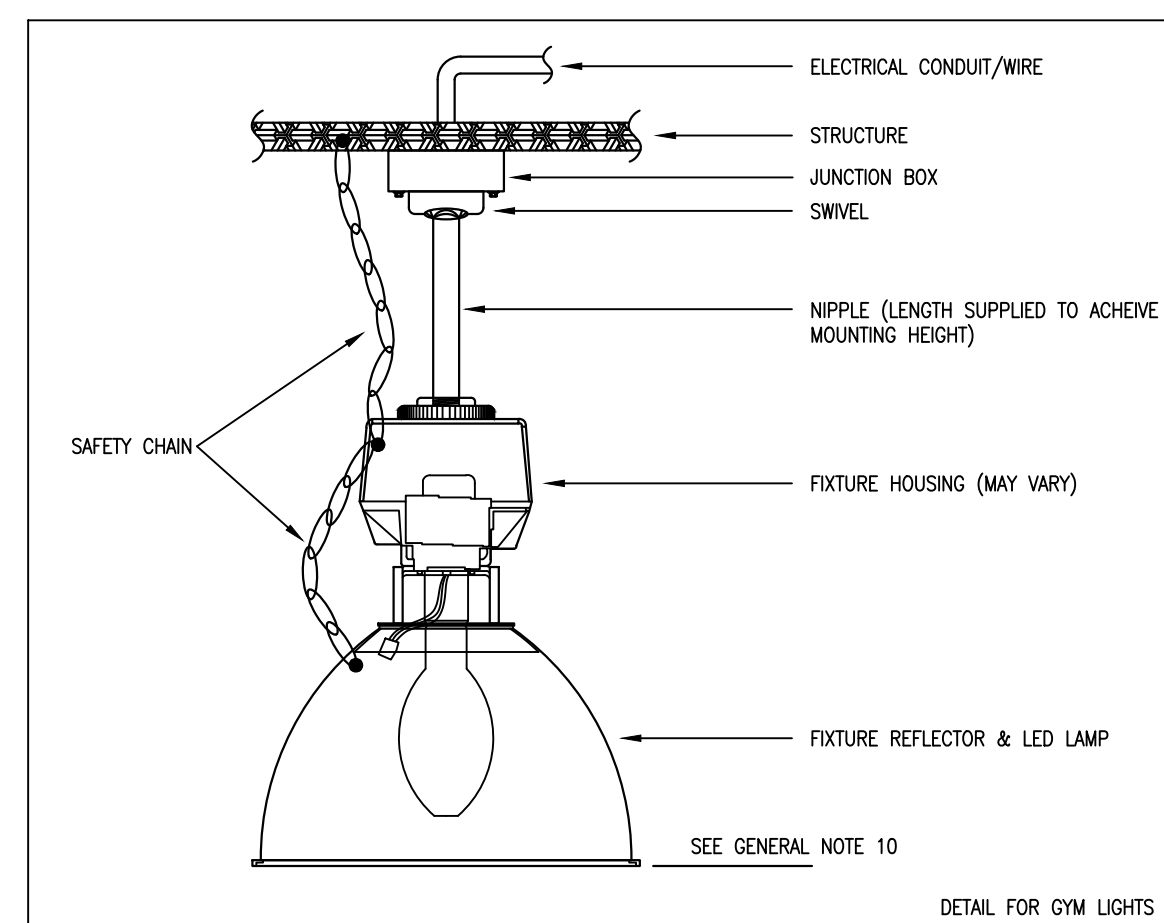

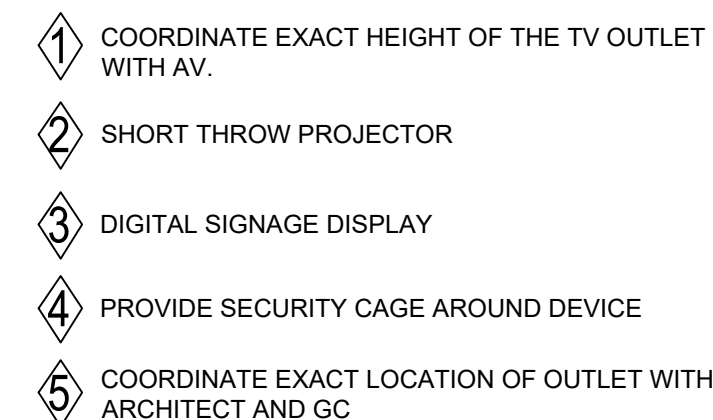


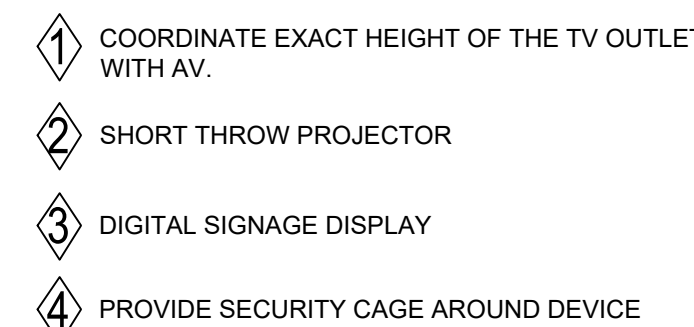


B:\1361\Pembroke Community Center\PembrokeCommunityCenter_BM380_FINAL_032821.rvt
5/26/2022 10:24:41 AM
Author

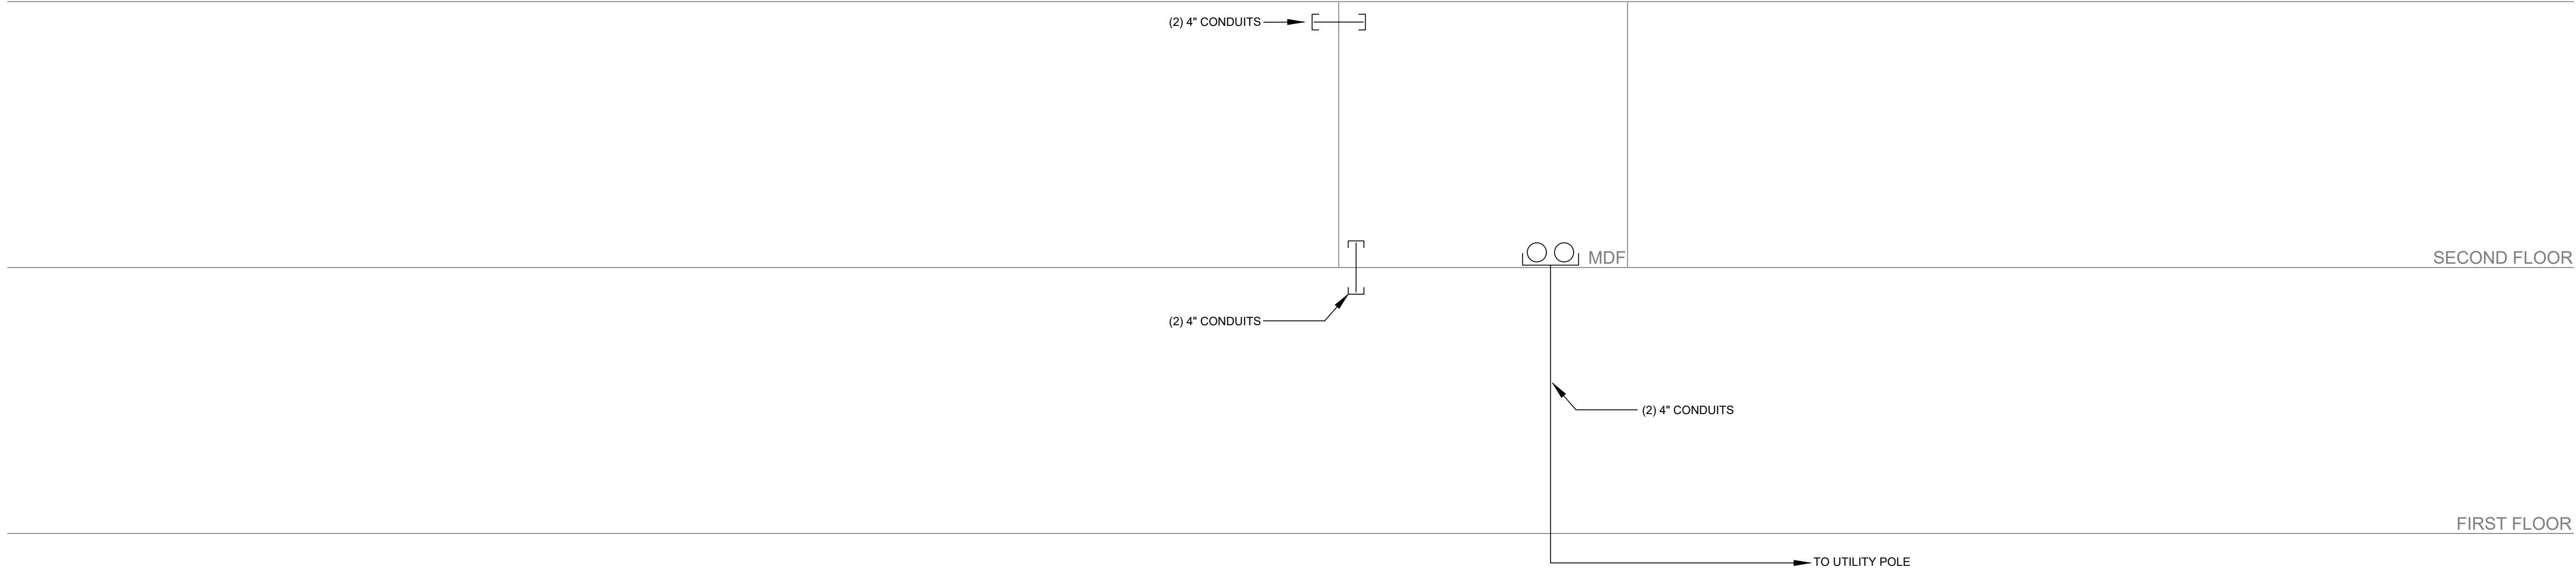

TELECOM RISER DIAGRAM

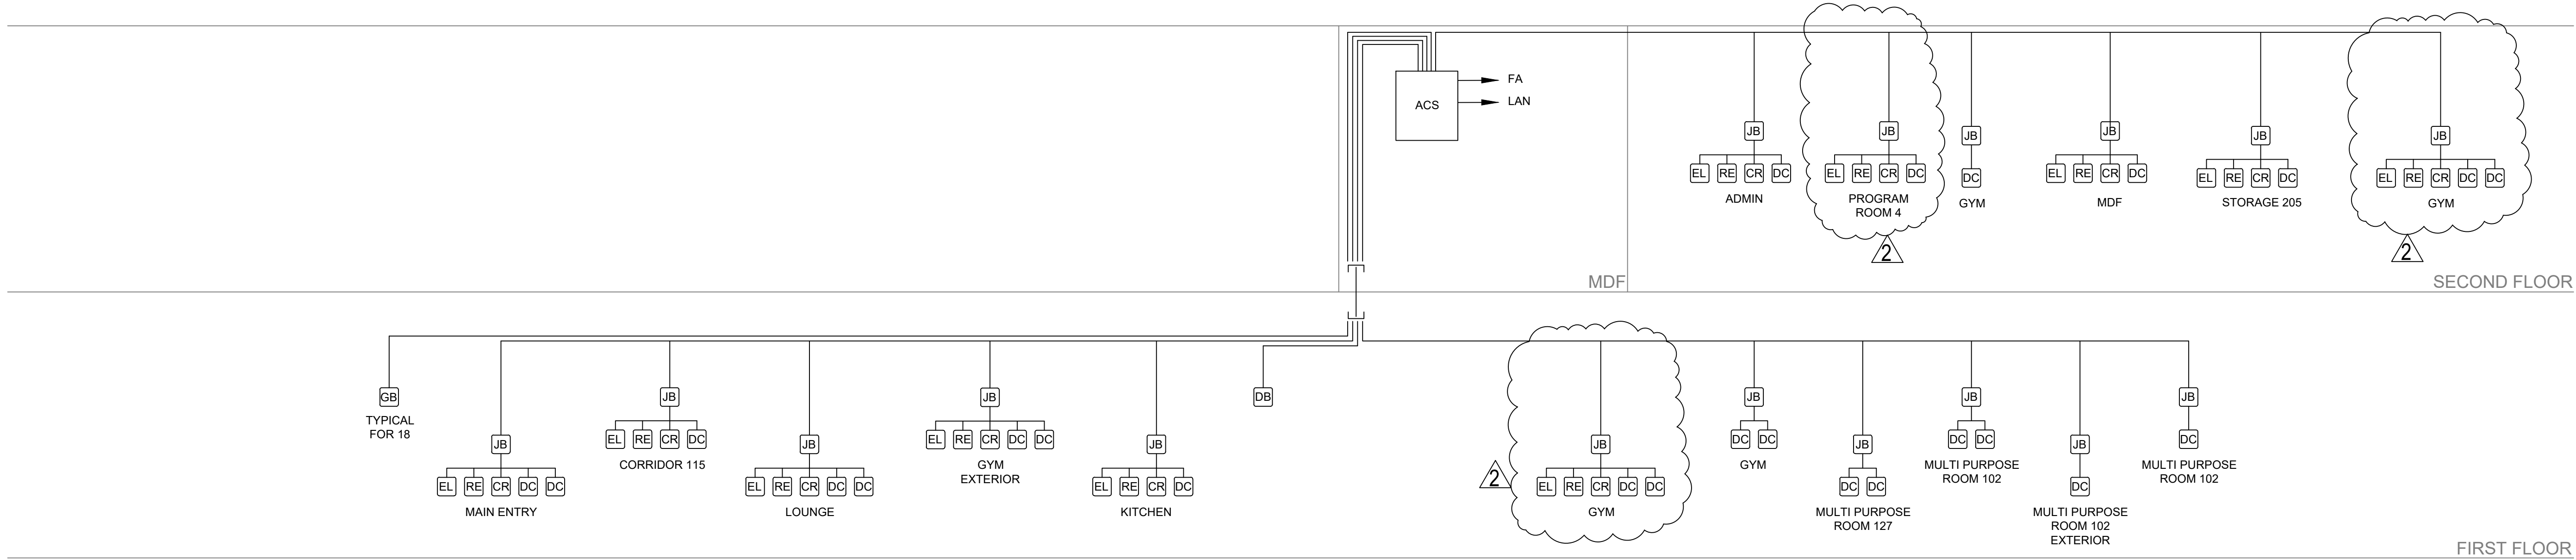

CARD ACESS RISER DIAGRAM

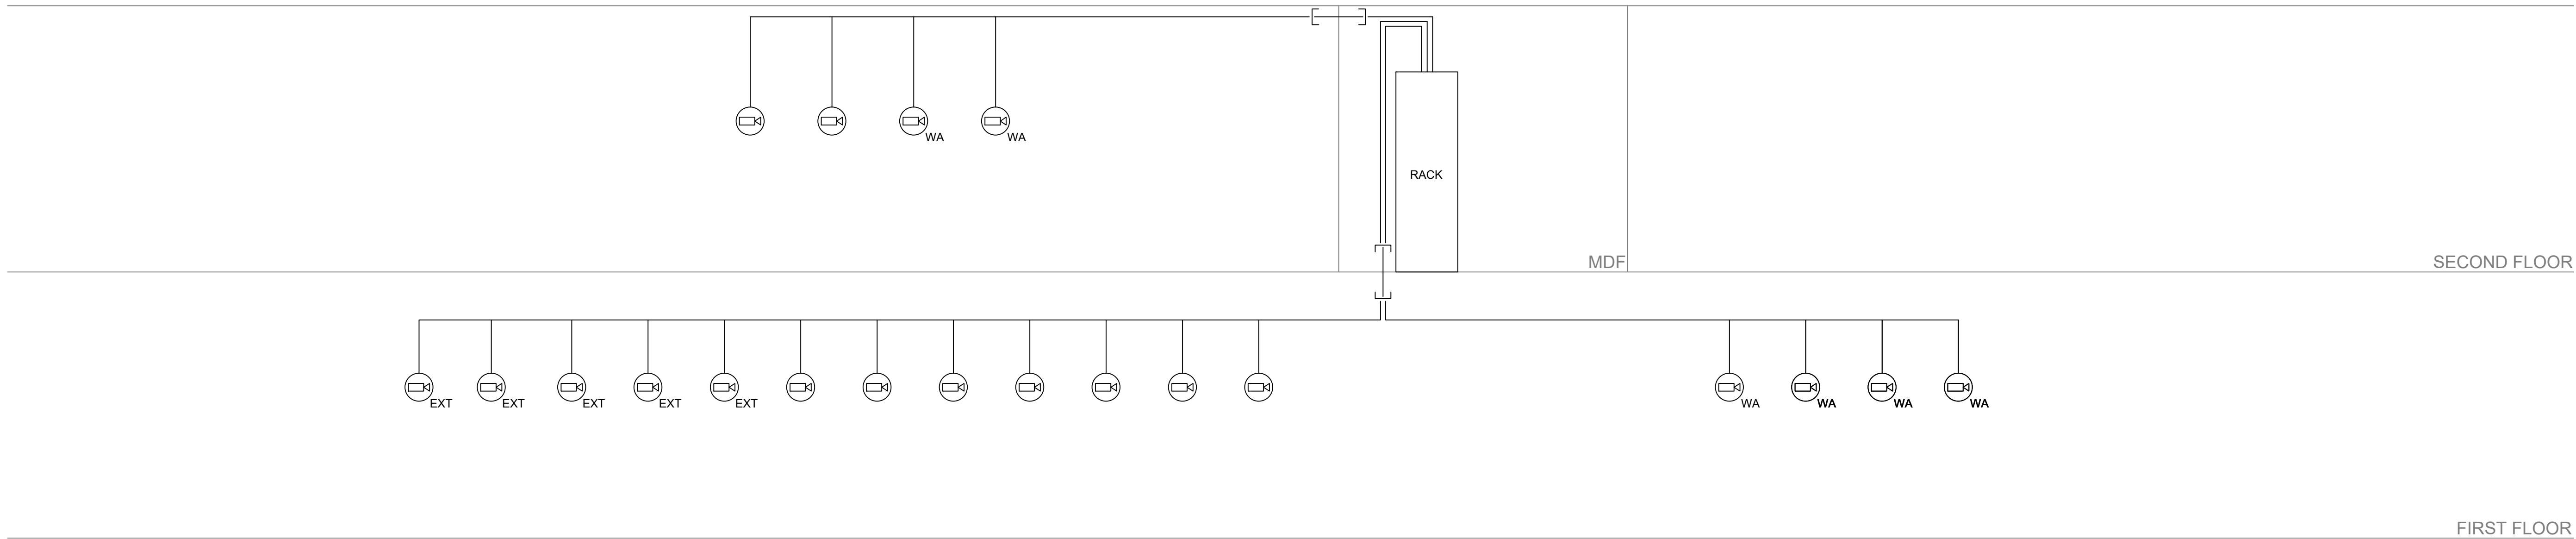

VIDEO SURVEILLANCE RISER DIAGRAM

- DRAWING NOTES**
- FA FIRE ALARM INTERFACE
 - LAN (1) CAT 6 20' PATCH CORD
 - CR (1) 22/6 SHIELDED
 - RE (1) 18/4 SHIELDED
 - DC (1) 18/2 SHIELDED
 - EL (1) 16/2 SHIELDED
 - CA (1) CAT6 4 PAIR UTP PLENUM
 - JB 12"X12"X4" JUNCTION BOX WITH HINGED COVER
 - GB (1) 18/4 SHIELDED
 - DB (1) 18/4 SHIELDED

ARCHITECT
bh+a
Bergmann Hendrie + Archetype, Inc.
9 Channel Center Street, Suite 300
Boston, MA 02210
(617) 350 0450

PROJECT NAME
**Pembroke
Community Center**
128 Center Street
Pembroke, MA, 02359

CLIENT
**Town of Pembroke
MA**
100 Center Street
Pembroke, MA, 02359

PROJECT TEAM
Civil Engineer & Site Surveyor
Merrill Engineers & Land Surveyors
427 Columbia Road
Haverhill, MA, 02359
(781) 826-9200
Landscape Architect
Kyle Zick Landscape Architecture, Inc.
36 Bromfield Street, Suite 202
Boston, MA, 02108
(617) 451-1018
Structural Engineer
Foley Buhl Roberts & Associates, Inc.
2150 Washington Street
Newton, MA, 02462
(617) 527-9600
MEP/FP Engineer
Allied Consulting Engineering Services
235 Littleton Road, Suite 5
Westford, MA, 01886
(978) 443-7888
Audio/Visual
Pro AV Systems
275 Billerica Road, Suite 3
Chelmsford, MA 01824
(978) 692-5111
Elevator Consultant
B Squared Engineering
169 Mill Brook Road
Stamford, CT, 06902
(203) 989-9029
Food Service Consultant
Crabtree McGrath Associates
161 West Main Street
Georgetown, MA 01833
(978) 552-8500
Technology and Security
Building Technology Consulting
992 Bedford Street
Bridgewater, MA 02424
(508) 819-1550

REVISIONS		
2	ADDENDUM 2	8/5/2022

DRAWING TITLE
**Technology
Risers**

DRAWING INFORMATION		
7/22/22		
DATE OF ISSUE		
Site Plan Review		
DESCRIPTION		
1/8" = 1'-0"	EO	
SCALE	DRAWN BY	
3453.00	Perkins	
PROJECT #	FILE NAME	

DRAWING NUMBER
T301
Copyright BH+A, Inc. V.2.1